IREDELL COUNTY HEALTH DEPARTMENT

STATESVILLE 704-878-5305 MOORESVILLE 704-664-5281

IMPROVEMENT PERMIT / AUTHORIZATION TO CONSTRUCT / OPERATION PERMIT / EXISTING SYSTEM INSPECTION

PERMIT# 18204 PIN# At of 2PC 15 4637-56-3212 DATE 1/2/01

OWNER OR CONTRACTOR Steve & Erin Channing PHONE: Business 799-1716 Home

ADDRESS 104 Tigris Ct. Apt D. Mooresville NC. 28117

LOCATION River Hwy - 150W TL Dealie Rd. TR Purple Finch to 2nd lot on (L)

SUBDIVISION Whippoorwill Woods BLOCK / SECTION 2 LOT 17 LOT AREA ~30,000 FT² SITE CLASS. PS DESIGN FLOW 360 L.T.A.R. .3

Septic Tank: 1000 Gallons; STB 794 Date 7/19/99
Pump Tank: Gallons; PT Date
Pump Make: Model Serial No.
Nitrification Field: No Fields 1 Square Feet 1200 Linear Feet 400
No Lines 4@100' Trench Width 3' Max Trench Bottom Depth 30" Gravel Depth 12"

[X] New System [ ] Repair System Type: I, (II), III, IV, V, VI
System Description: GR - CONVENTIONAL
Repair System Description: SAME
Maintenance Agreement Required: [ ] Yes [ ] No

[X] House/Mod. Home No. Bedrooms 3
[ ] Mobile Home No. Bathrooms 3
[ ] Business No. Employees
[ ] Other


[ ] Slab [X] Crawl Space [ ] Basement w/plumbing [ ] Basement wo/plumbing

Water Supply:
[ ] Individual
[ ] Public
[X] Community
on Lot 98


Comments:/Conditions:

Comments:/Conditions:

INITIAL SITE SKETCH (1" = 50')

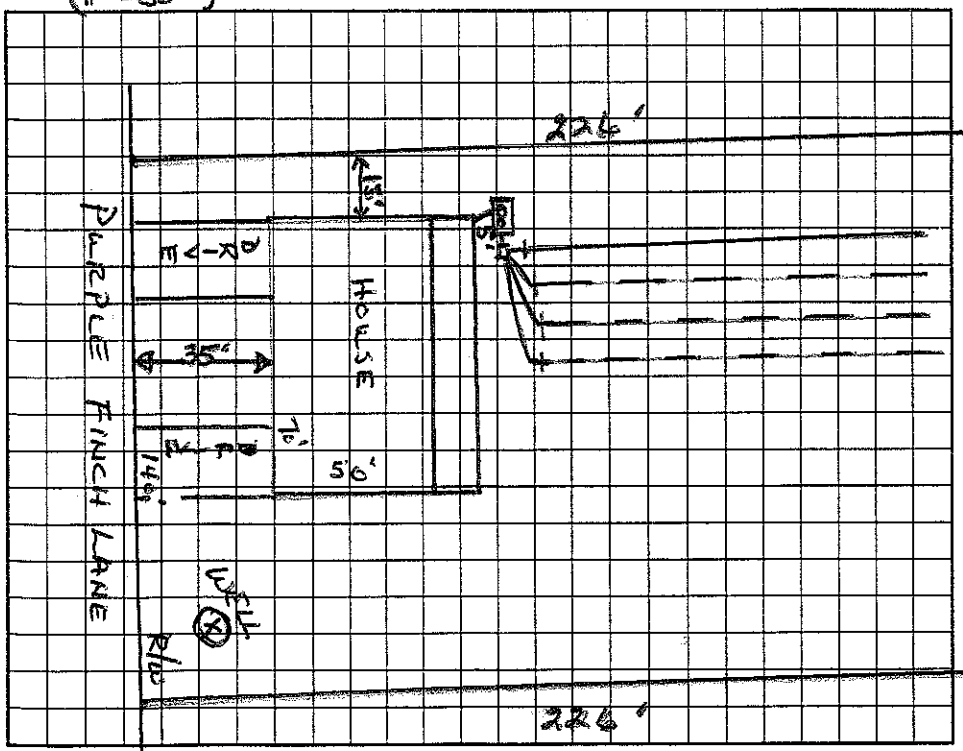

AS BUILT SKETCH

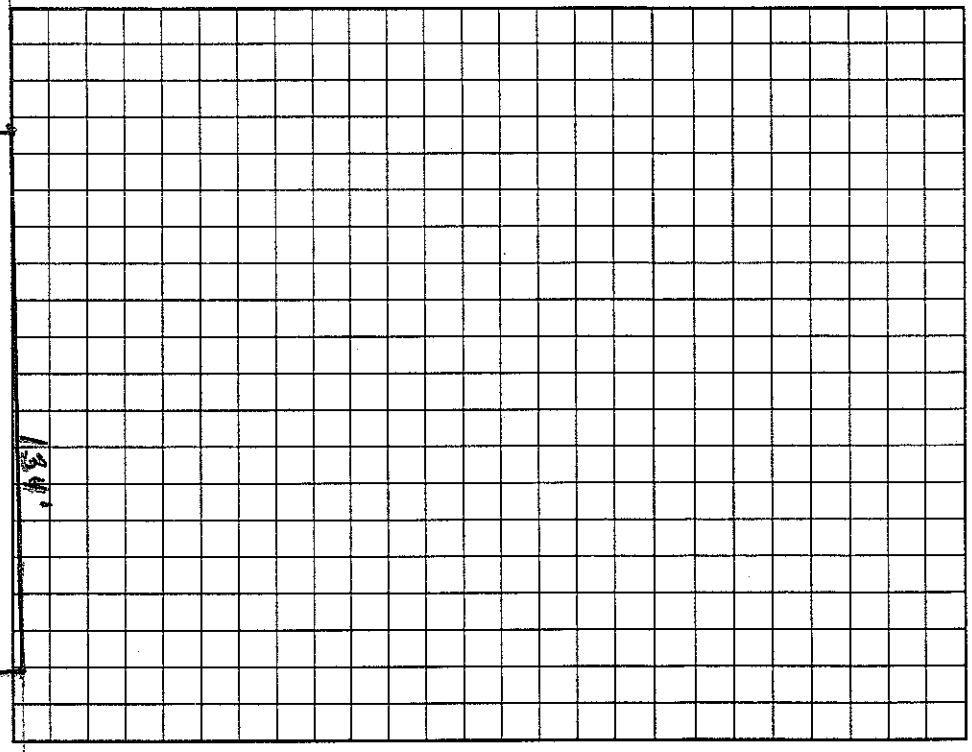

Permit can be suspended or revoked if any false information is supplied toward securing the permit/any unauthorized changes are made to the site/any unauthorized changes are made in the installation of the system. Improvement Permit with plat valid without expiration. Improvement Permit with site plan valid for sixty months. Authorization to Construct is valid for a period equal to that of Improvement Permit – not to exceed sixty months.

Signed: Erin Channing date 1/3/01 Installed by: Curt Dunnmid

Improvement Permit by: Wesley Sparks R.S. date 1/2/01 Operation Permit by: Wesley Sparks R.S. date 7/12/01

Authorization to Construct by: Wesley Sparks R.S. date 1/2/01 Existing System Inspection by: date

HEALTH DEPT. COPY: WHITE OWNER COPY (FINAL): YELLOW OWNER COPY (INITIAL): PINK