# IREDELL COUNTY HEALTH DEPARTMENT

Const. Auth. · STATESVILLE 704-878-5305 MOORESVILLE 704-664-5281

## IMPROVEMENT PERMIT / ~~CERTIFICATE OF COMPLETION~~ / OPERATION PERMIT / EXISTING SYSTEM INSPECTION

PROPERTY DESCRIPTION NO. 18204 DATE Jan 8, '97 TAX MAP NO. part of 2815 Watershed: ☑ Yes ☐ No

OWNER OR CONTRACTOR Genesis Dev. Ltd. PHONE: Business _____ Home _____

ADDRESS PO Box 363 Troutman NC

LOCATION 150 W to Doolie to R Purple Finch on left

SUBDIVISION Whippoorwill Woods BLOCK / SECTION 4 LOT 17 LOT AREA 30,132 ft² SITE CLASS. B pre 1996 DESIGN FLOW 460 gpd L.T.A.R. .3

Septic Tank: 1500 Gallons; STB _____ Date _____

Pump Tank: _____ Gallons; PT _____ Date _____

Pump Make: _____ Model _____ Serial No. _____

Nitrification Field: No Fields 1 Square Feet 1200 Linear Feet 400

No Lines 4 @ 100' Trench Width 36" Max Trench Bottom Depth ~30" Gravel Depth N/A

☑ New System ☐ Repair System Type: I, II, III, IV, V, VI

System Description: gravity plastic chambered

Repair System Description: Same

Maintenance Agreement Required: ☐ Yes ☑ No

☐ House/Mod. Home No. Bedrooms 4/4

☐ Mobile Home No. Bathrooms 4/4

☐ Business No. Employees _____

☑ Other Duplex Apt


☑ Slab ☐ Crawl Space ☐ Basement w/plumbing ☐ Basement wo/plumbing

Water Supply:
☑ Individual
☐ Community
☐ Public on '96


Comments:

Comments:

**INITIAL SITE SKETCH**

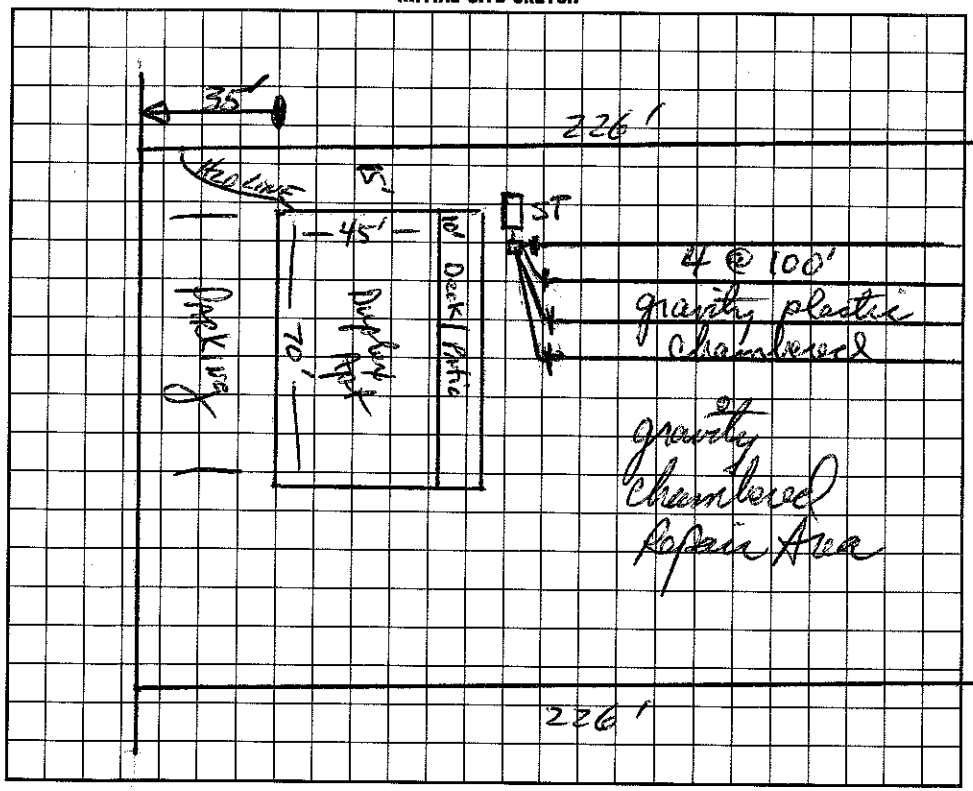


**AS BUILT SKETCH**

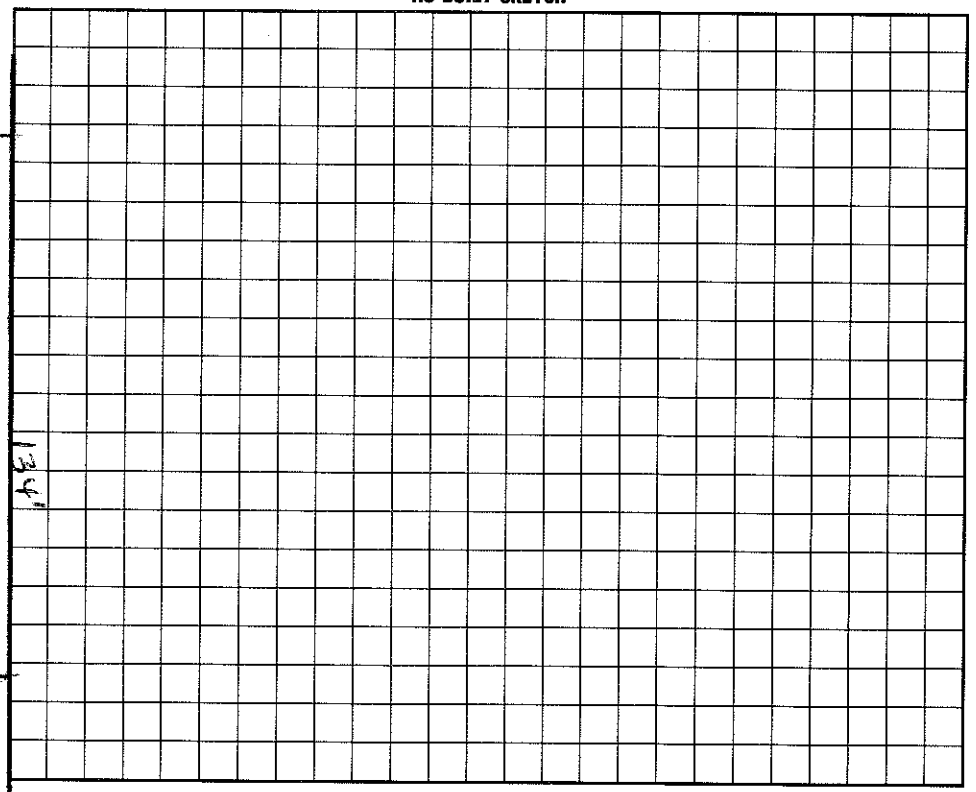


I understand that this permit can be suspended or revoked if any false information is supplied toward securing the permit/any unauthorized changes are made to the site/any unauthorized changes are made in the installation of the system. Improvement Permit is valid for ~~60 months~~ from date of issuance.

Signed: X _____

Improvement Permit by: _____ date _____

~~Existing System Inspection by:~~ CONSTRUCTION AUTHORIZATION _____ date _____

Installed by: _____

Certificate of Completion by: _____ date _____

Operation Permit by: _____ date _____

HEALTH DEPT. COPY: WHITE INSPECTION COPY (FINAL): GREEN OWNER COPY (FINAL): YELLOW INSPECTION COPY (INITIAL): PINK OWNER COPY (INITIAL): GOLD