IREDELL COUNTY HEALTH DEPARTMENT

ST[illegible] 704-878-5305 MOORESVILLE 704-664-5281

25.00 Paid 2100

IMPROVEMENT PERMIT / AUTHORIZATION TO CONSTRUCT / OPERATION PERMIT / EXISTING SYSTEM INSPECTION

PERMIT# 102201 PIN# 4637-56-3507 DATE 1/16/02

OWNER OR CONTRACTOR Genesis Developers PHONE: Business 704-664-3900 Home

ADDRESS 249 Williamson Rd Mooresville NC 28117

LOCATION 150W, TL Doolie, TR Purple Finch 2nd on Rt

SUBDIVISION Whippoorwill Woods BLOCK / SECTION II LOT 6 LOT AREA 0.98AC SITE CLASS. 05 DESIGN FLOW 360 L.T.A.R. 0.5

Septic Tank: 1000 Gallons; STB 1007 Date 7/13/02
Pump Tank: Gallons; PT Date
Pump Make: Model Serial No.
Nitrification Field: No Fields 1 Square Feet 1200 Linear Feet 400
No Lines 4 @ 100' Trench Width 36" Max Trench Bottom Depth 36" Gravel Depth 12"

☒ New System ☐ Repair System Type: I. II. III. IV. V. VI
System Description: Gravity Conv.
Repair System Description: 25% Reduction
Maintenance Agreement Required: ☐ Yes ☒ No


☒ House/Mod. Home No. Bedrooms 3
☐ Mobile Home No. Bathrooms 2
☐ Business No. Employees
☐ Other
☐ Slab ☒ Crawl Space ☐ Basement w/plumbing ☐ Basement wo/plumbing

Water Supply: ☑ Individual ☐ Public ☐ Community


Comments:/Conditions:

Comments:/Conditions:
2 Lines checked GR 8/27/02

INITIAL SITE SKETCH 1"=50'

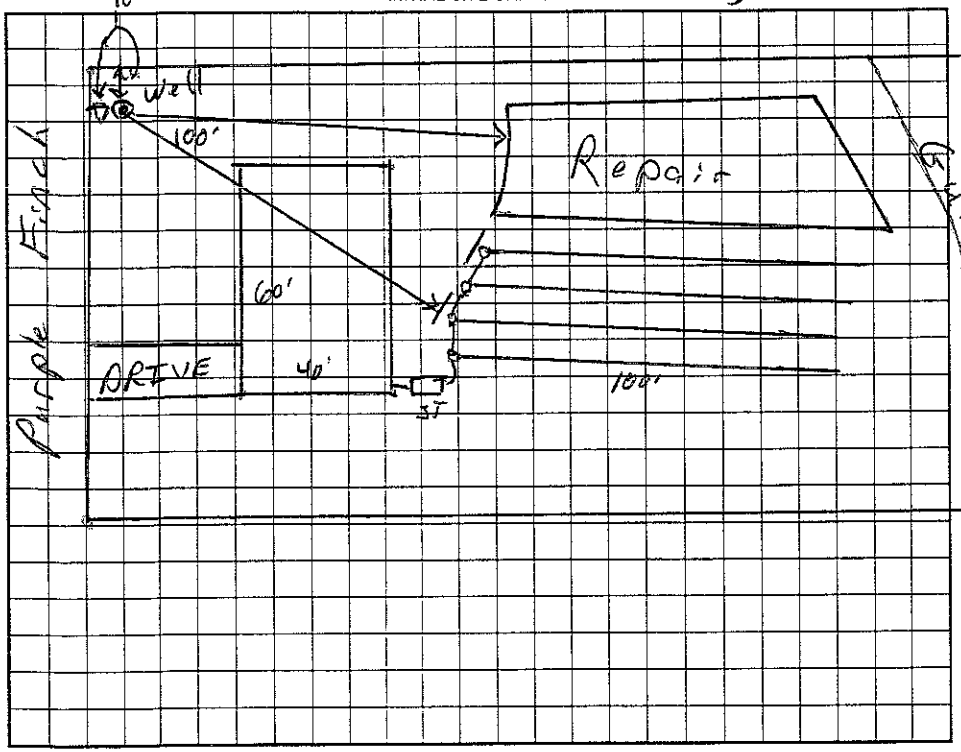

AS BUILT SKETCH

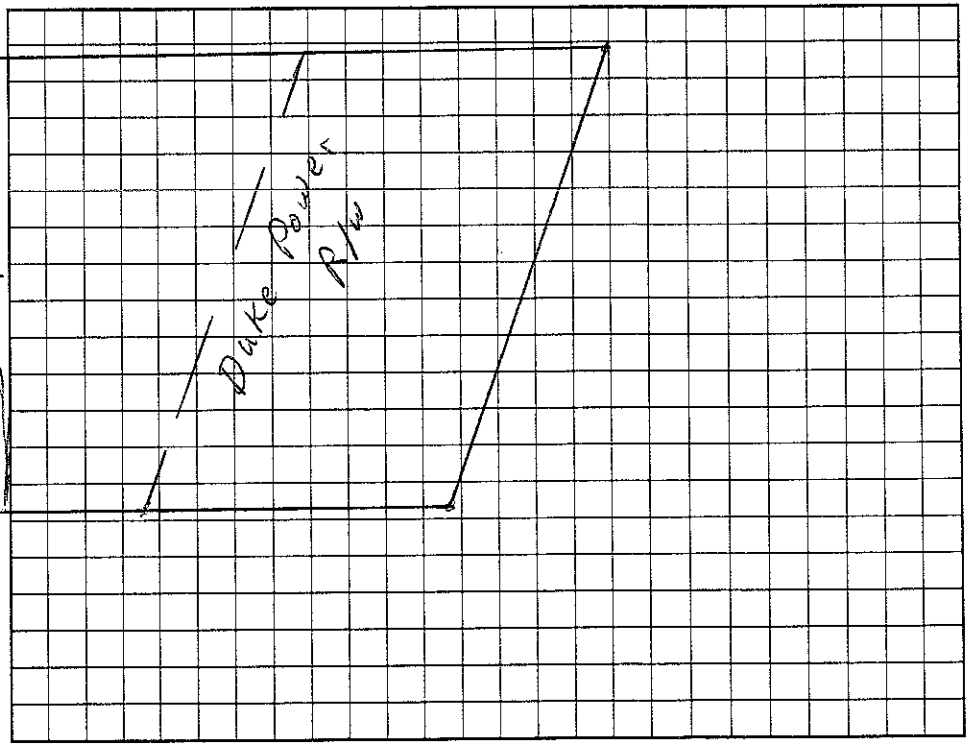

Permit can be suspended or revoked if any false information is supplied toward securing the permit/any unauthorized changes are made to the site/any unauthorized changes are made in the installation of the system. Improvement Permit with plat valid without expiration. Improvement Permit with site plan valid for sixty months. Authorization to Construct is valid for a period equal to that of Improvement Permit – not to exceed sixty months.

Signed: Donna Rogers date 2/22/02 Installed by: Statesville Backhoe

Improvement Permit by: RS date 1/16/02 Operation Permit by: RS date 8/29/02

Authorization to Construct by: RS date 1/16/02 Existing System Inspection by: date

HEALTH DEPT. COPY: WHITE OWNER COPY (FINAL): YELLOW OWNER COPY (INITIAL): PINK