3sc-4a

# IREDELL COUNTY HEALTH DEPARTMENT

STATESVILLE 704-878-5305 MOORESVILLE 704-664-5281

## IMPROVEMENT PERMIT / CERTIFICATE OF COMPLETION / OPERATION PERMIT / EXISTING SYSTEM INSPECTION

PROPERTY DESCRIPTION NO. 18189 DATE Feb 20, 195 TAX MAP NO. part of 2PC15 4637564933 Watershed: ☑ Yes ☐ No

OWNER OR CONTRACTOR Genesis Dev Ltd / Jon Grigoriou (Tim Perry) PHONE: Business 664-3400 Home

ADDRESS PO Box 363, Terrell, NC 28682

LOCATION 150 M TL Doolie Rd 2nd lot on Right past Shepherd Vol. Fire Dept.

SUBDIVISION Whippoorwill Woods BLOCK / SECTION 2 LOT 2 LOT AREA 31837 SF SITE CLASS. B pre 1956, 1957 DESIGN FLOW 480 gpd L.T.A.R. .3

Septic Tank: 1500 Gallons; STB 1014 (3) Date 7-1-96

Pump Tank: Gallons; PT Date

Pump Make: Model Serial No.

Nitrification Field: No Fields 1 Square Feet 1600 Linear Feet 533

No Lines 3+3 Trench Width 36" Max Trench Bottom Depth 36" Gravel Depth 12"

☑ New System ☐ Repair System Type: I, (II), III, IV, V, VI

System Description: gravity conventional

Repair System Description: Mod/Alt grav/LP

Maintenance Agreement Required: ☐ Yes ☑ No

☐ House/Mod. Home No. Bedrooms 4

☐ Mobile Home No. Bathrooms 2

☐ Business No. Employees

☑ Other Duplex Apt


☐ Slab ☑ Crawl Space ☐ Basement w/plumbing ☐ Basement wo/plumbing

Water Supply: ☑ Individual ☐ Community ☐ Public

Comments: Laterals to follow contour. Well that serves this lot is at rear of lot 3. This lot contains a well easement for lots 8, 9, 10 at rear within 5' of PL w/ Lot 3 and Lot 9.

Comments: DEVELOPER PERMIT

INITIAL SITE SKETCH

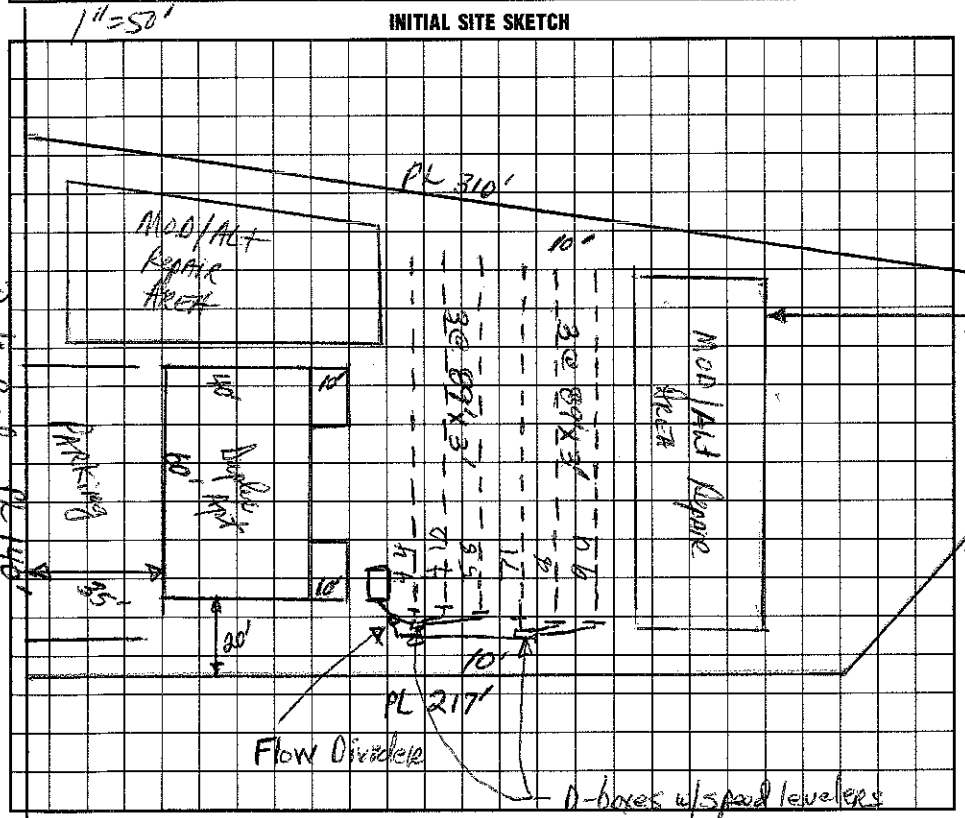


AS BUILT SKETCH

I understand that this permit can be suspended or revoked if any false information is supplied toward securing the permit/any unauthorized changes are made to the site/any unauthorized changes are made in the installation of the system. Improvement Permit is valid for 60 months from date of issuance.

Signed:

Improvement Permit by: D.C. Harmon, RS date 2/20/95

Existing System Inspection by: D.C. Harmon, RS date 6-17-96

Authorization to Construct

Installed by: Wayne Clontz

Certificate of Completion by: date

Operation Permit by: C. Ray Freeman EHS date 9/13/96

HEALTH DEPT. COPY: WHITE INSPECTION COPY (FINAL): GREEN OWNER COPY (FINAL): YELLOW INSPECTION COPY (INITIAL): PINK OWNER COPY (INITIAL): GOLD