IREDELL COUNTY HEALTH DEPARTMENT

Statesville Office (704) 878-5305 Mooresville Office (704) 660-3625 PERMIT # 217374

IMPROVEMENT PERMIT / AUTHORIZATION TO CONSTRUCT / OPERATION PERMIT / EXISTING SYSTEM

PIN # 4637-61-3610.000

APPLICANT: Rowland Dev. Corp. APPLICANT ADDRESS: 2231 Hwy 152 E. China Grove NC 28023

SITE ADDRESS: 254 Oak Tree Rd. Mooresville NC PHONE: 704-506-0556 ALT. PHONE: * 704-202-1176 *

SITE DIRECTIONS: 85R, TR Oak Tree Rd., Site on R Across from School.

SUBDIVISION: Grand Oaks Subd. SECTION: — LOT # 3 LOT AREA: .53 Acre DESIGN FLOW: 480 GPD L.T.A.R.: .3 I / .275 R


Septic Tank	1000 (gal)	STB	825	Date	8-13-16	☑ New System ☐ Repair ☐ Expansion	System Type: I II (III) IV V VI	☑ Residence	No. Bedrooms 4
Pump Tank	(gal)	PT		Date		System Description:	25% Reduction - Gravity	☐ Business	No. Persons 8
Pump Make		Model		Serial #		Repair System Description:	LP-PPBPS	☐ Other	No. Employees
# Nitrification Fields	1	# Lines	8 @ 50'	Linear Ft:	400'	Maintenance Agreement Required:	☐ YES ☑ NO	☐ Slab	☒ Crawl Space
Trench Width	36"	Max. Trench Bottom Depth	* 24" - 34" * Downhill	Gravel Depth	N/A	☒ GRAVITY	☐ PRESSURE	☐ Basement w/plumbing	☐ Basement w/o plumbing

Water Supply: ☐ Private ☒ Public ☐ Community


Comments / Conditions: Design Slightly Off Contour. Maintain Trench Bottom Depth. That is Specified.

No Vehicular traffic over Septic System.

INITIAL SITE SKETCH

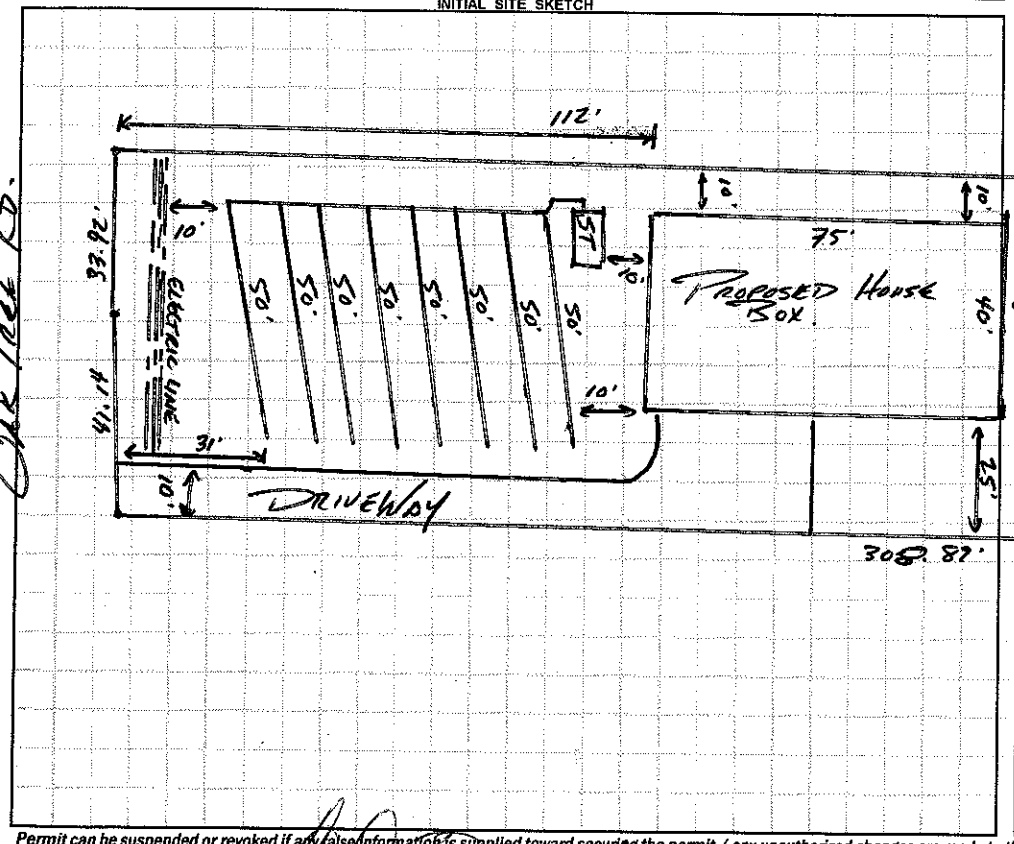

AS BUILT SKETCH

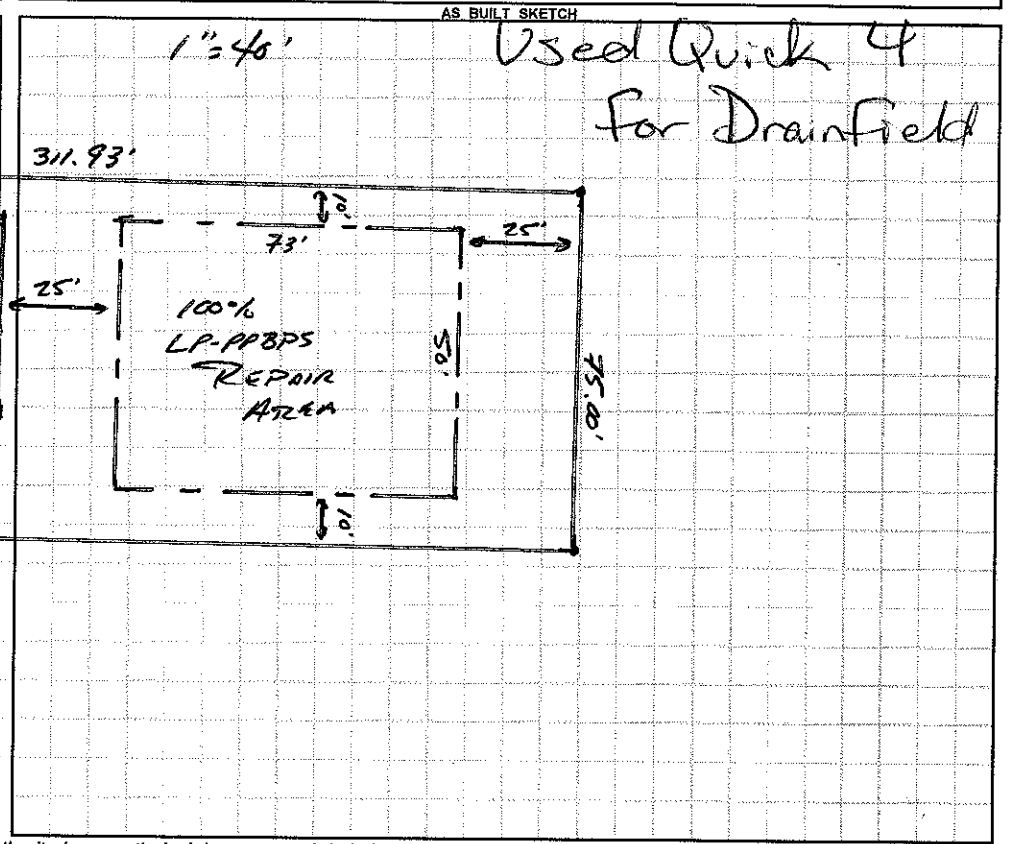

Permit can be suspended or revoked if any false information is supplied toward securing the permit / any unauthorized changes are made to the site / any unauthorized changes are made in the installation of the system. **CONTACT A LOCATOR SERVICE PRIOR TO ANY EXCAVATION**

☐ **IMPROVEMENT PERMIT** *with plat valid without expiration.* ☒ **IMPROVEMENT PERMIT** *with site plan valid for 60 mos.* ☐ **AUTHORIZATION TO CONSTRUCT** *valid for period equal to IMPROVEMENT PERMIT--not to exceed 60 mo.*

Owner / Applicant Signature: Date: 4/27/16 Installed by: Rowan Septic

IMPROVEMENT PERMIT by: APPROVED APR 21 2016 OPERATION PERMIT by: Marian Dolbow RS Date: 9/20/16

AUTHORIZATION TO CONSTRUCT by: APPROVED APR 22 2016 Existing System Inspected by: Date:

Health Dept. Copy - WHITE Applicant (Final Approval) - YELLOW Applicant (Conditional Approval) - PINK