IREDELL COUNTY HEALTH DEPARTMENT

Statesville Office (704) 878-5305 Mooresville Office (704) 660-3625 PERMIT # Z10845

IMPROVEMENT PERMIT / AUTHORIZATION TO CONSTRUCT / OPERATION PERMIT / EXISTING SYSTEM

PIN # 4637613618

APPLICANT: Rowland Development APPLICANT ADDRESS: 2231 Hwy 152 E. China Grove

SITE ADDRESS: 258 Oak Tree Rd. - Mooresville PHONE: 704-506-0556 ALT. PHONE:

SITE DIRECTIONS: BSR, TR Oak Tree, on R

SUBDIVISION: Grand Oaks SECTION: — LOT # 2 LOT AREA: .5AC DESIGN FLOW: 480 L.T.A.R.: .3

Septic Tank 1000 (gal) STB 825 Date 8-12-16
Pump Tank (gal) PT Date
Pump Make Model Serial #
Nitrification Fields 1 # Lines 8@50' Linear Ft: 400'
Trench Width 36" Max. Trench Bottom Depth * 24" * Gravel Depth —


☒ New System ☐ Repair ☐ Expansion System Type: I II III IV V VI
System Description: 25% Reduction
Repair System Description: Panel Block
Maintenance Agreement Required: ☐ YES ☒ NO
☒ GRAVITY ☐ PRESSURE

☒ Residence ☐ Business ☐ Other ☐ Slab ☐ Basement w/plumbing
No. Bedrooms 4 No. Persons No. Employees ☒ Crawl Space
Water Supply: ☐ Private ☒ Public ☐ Community
☐ Basement w/o plumbing


Comments / Conditions:

~~* Hold AC until lot is Recorded *~~

INITIAL SITE SKETCH

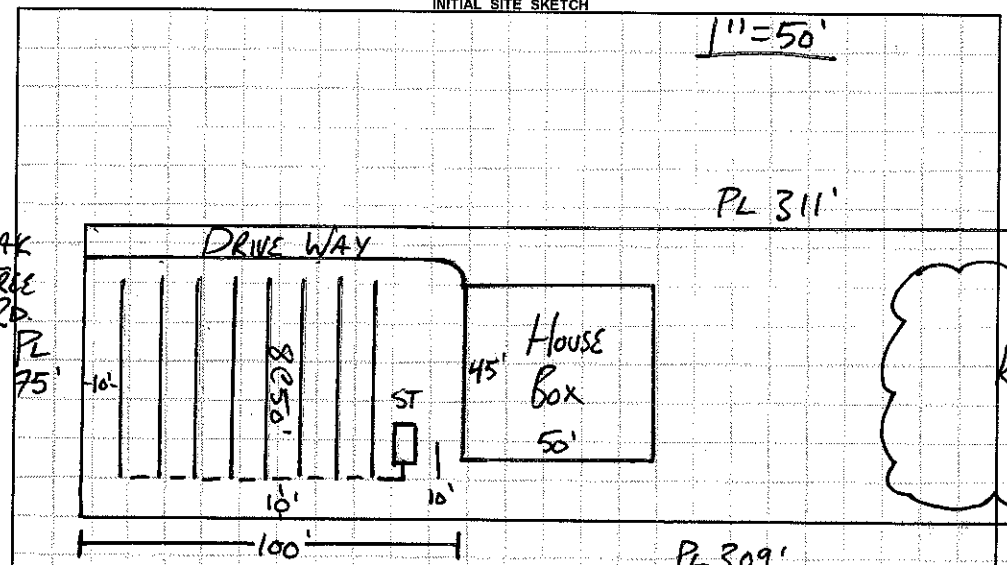

AS BUILT SKETCH

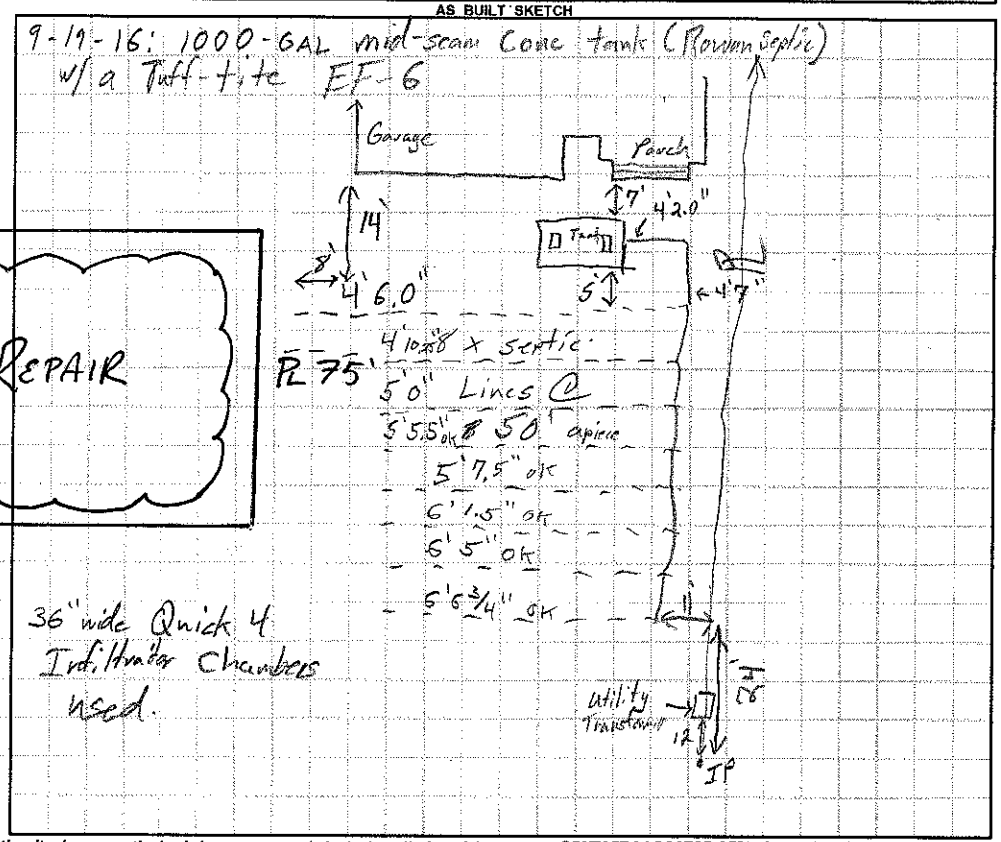

Permit can be suspended or revoked if any false information is supplied toward securing the permit / any unauthorized changes are made to the site / any unauthorized changes are made in the installation of the system. **CONTACT A LOCATOR SERVICE PRIOR TO ANY EXCAVATION**

☐ **IMPROVEMENT PERMIT** *with plat* valid without expiration. ☒ **IMPROVEMENT PERMIT** *with site plan* valid for 60 mos. ☒ **AUTHORIZATION TO CONSTRUCT** valid for period equal to IMPROVEMENT PERMIT--not to exceed 60 mo.

Owner / Applicant Signature: Date: 8/27/15

IMPROVEMENT PERMIT by: APPROVED Date: JUL 31 2015

AUTHORIZATION TO CONSTRUCT by: APPROVED Date: APR 27 2016

Installed by: Rowan Septic [Kevin Kirkpatrick]

OPERATION PERMIT by: Date: 9-19-16

Existing System Inspected by: Date:

Health Dept. Copy - WHITE Applicant (Final Approval) - YELLOW Applicant (Conditional Approval) - PINK