AW 200 Rowan

IREDELL COUNTY HEALTH DEPARTMENT

Statesville Office (704) 878-5305 Mooresville Office (704) 660-3625 PERMIT # 210844

IMPROVEMENT PERMIT / AUTHORIZATION TO CONSTRUCT / OPERATION PERMIT / EXISTING SYSTEM

PIN # 4637613716

APPLICANT: Rowland Development APPLICANT ADDRESS: 2231 Hwy 152 E. China Grove

SITE ADDRESS: 262 Oak Tree Rd. - Mooresville PHONE: 704-506-0556 ALT. PHONE:

SITE DIRECTIONS: BSR TR Oak Tree, on R

SUBDIVISION: Grand Oaks SECTION: — LOT # 1 LOT AREA: .54C DESIGN FLOW: 480 L.T.A.R.: .3


Septic Tank	1000 (gal)	STB	825	Date	1-8-2016	☒ New System ☐ Repair ☐ Expansion	System Type: I II (III) IV V VI	☒ Residence	No. Bedrooms 4
Pump Tank	(gal)	PT		Date		System Description:	25% Reduction	☐ Business	No. Persons
Pump Make		Model		Serial #		Repair System Description:	Panel Block	☐ Other	No. Employees
# Nitrification Fields	1	# Lines	8@50'	Linear Ft:	400'	Maintenance Agreement Required:	☐ YES ☒ NO	☐ Slab	☒ Crawl Space
Trench Width	36"	Max. Trench Bottom Depth	*14"*	Gravel Depth	—		☒ GRAVITY ☐ PRESSURE	☐ Basement w/plumbing	☐ Basement w/o plumbing

Water Supply: ☐ Private ☒ Public ☐ Community


Comments / Conditions: *MIN 4" OF TYPE III OR IV Soil Cover Required Over Drawfield*

Hold AC Until Lots are Recorded
Plat Received 9/1/15 LL
House Proposed is Deeper than Proposed House Box Should Be OK But House Cannot Shift Toward

INITIAL SITE SKETCH

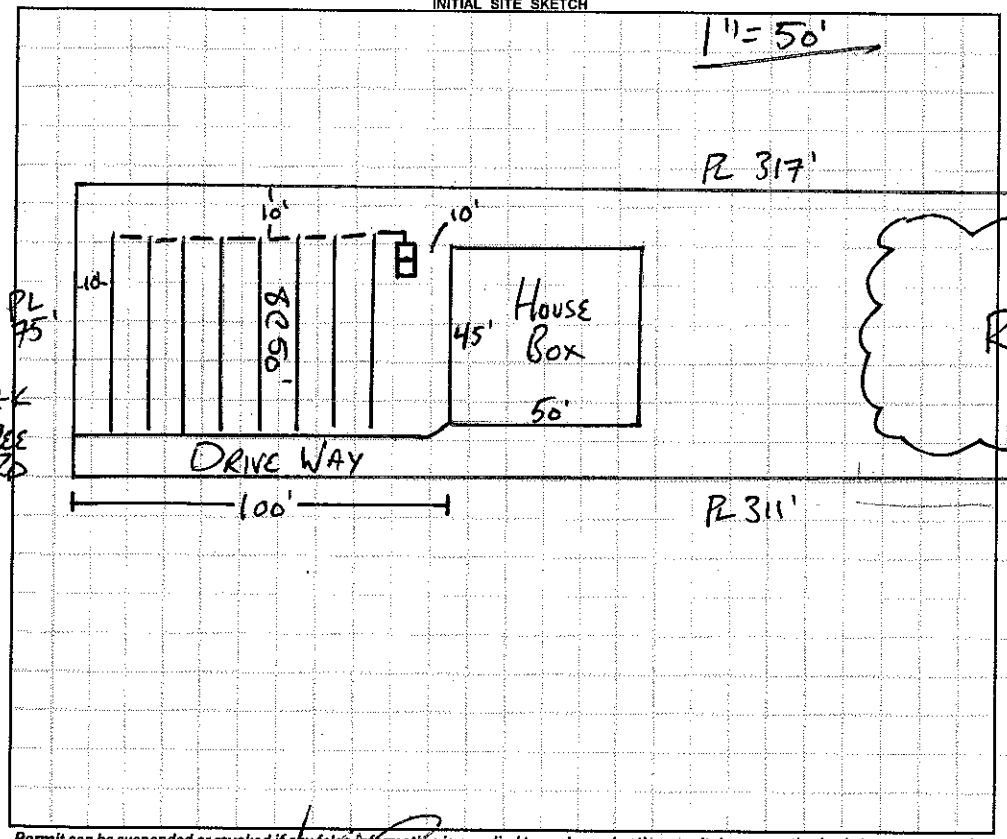

AS BUILT SKETCH

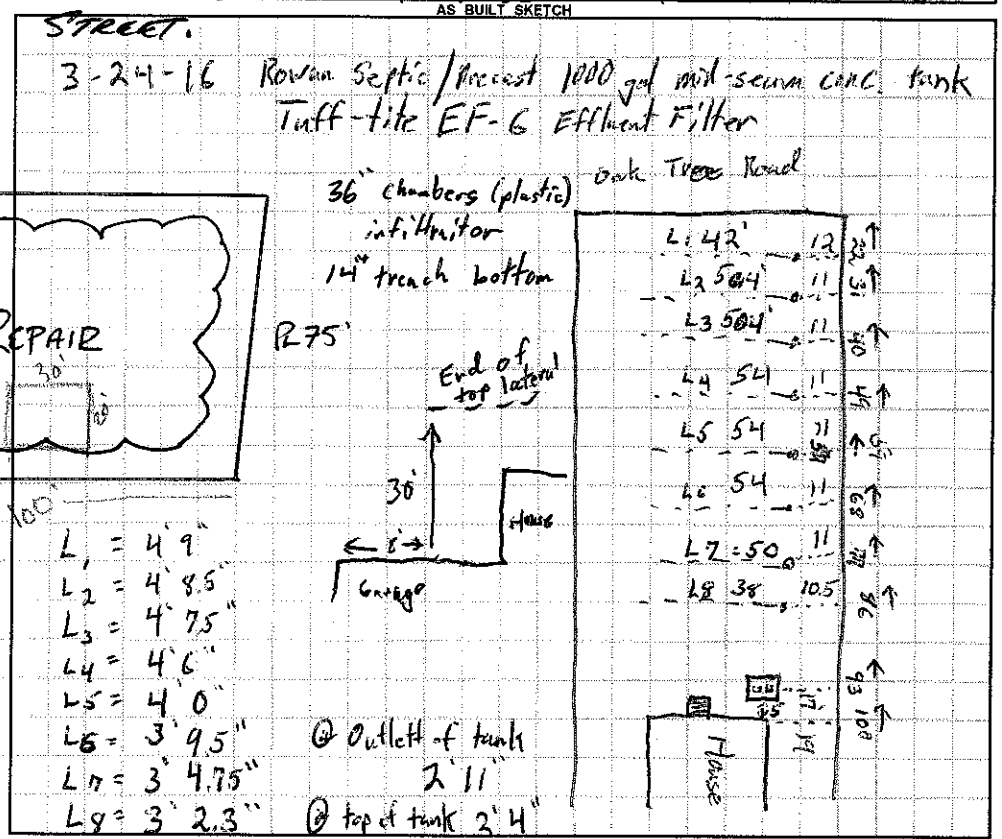

Permit can be suspended or revoked if any false information is supplied toward securing the permit / any unauthorized changes are made to the site / any unauthorized changes are made in the installation of the system. **CONTACT A LOCATOR SERVICE PRIOR TO ANY EXCAVATION**

☐ **IMPROVEMENT PERMIT** *with plat valid without expiration.* ☒ **IMPROVEMENT PERMIT** *with site plan valid for 60 mos.* ☒ **AUTHORIZATION TO CONSTRUCT** *valid for period equal to IMPROVEMENT PERMIT--not to exceed 60 mo.*

Owner / Applicant Signature: Date: 8/27/15 Installed by: Rowan Septic - Kevin Kirkpatrick

IMPROVEMENT PERMIT by: APPROVED Date: JUL 31 2015 OPERATION PERMIT by: Shawn Shuck Date: 3-24-16

AUTHORIZATION TO CONSTRUCT by: APPROVED Date: SEP 01 2015 Existing System Inspected by: Date:

Health Dept. Copy - WHITE Applicant (Final Approval) - YELLOW Applicant (Conditional Approval) - PINK