IREDELL COUNTY HEALTH DEPARTMENT

Statesville Office (704) 878-5305 Mooresville Office (704) 660-3625 PERMIT # 217623

IMPROVEMENT PERMIT / AUTHORIZATION TO CONSTRUCT / OPERATION PERMIT / EXISTING SYSTEM

PIN # 4637-61-3716

APPLICANT: ROWLAND DEV. CORP. APPLICANT ADDRESS: 2231 HWY 152 E. CHINA GROVE

SITE ADDRESS: 202 OAK TREE RD. - MOORESVILLE PHONE: 704-506-0556 ALT. PHONE:

SITE DIRECTIONS: BSR, TR OAK TREE, ON R

SUBDIVISION: GRAND OAKS SECTION: — LOT # 1 LOT AREA: .5AC DESIGN FLOW: 480 L.T.A.R.: .3

Septic Tank ____ (gal) STB ____ Date ____
Pump Tank ____ (gal) PT ____ Date ____
Pump Make ____ Model ____ Serial # ____
Nitrification Fields ____ # Lines ____ Linear Ft: ____
Trench Width ____ Max. Trench Bottom Depth ____ Gravel Depth —

EXISTING

☐ New System ☐ Repair ☐ Expansion System Type: I II (III) IV V VI
System Description: 25% REDUCTION
Repair System Description: PANEL BLOCK
Maintenance Agreement Required: ☐ YES ☒ NO
☒ GRAVITY ☐ PRESSURE


☐ Residence No. Bedrooms 4
☐ Business No. Persons ____
☒ Other No. Employees ____
☒ Slab ☐ Crawl Space
☐ Basement w/plumbing ☐ Basement w/o plumbing

Water Supply: ☐ Private ☒ Public ☐ Community


Comments / Conditions:

30'X20' GARAGE

INITIAL SITE SKETCH

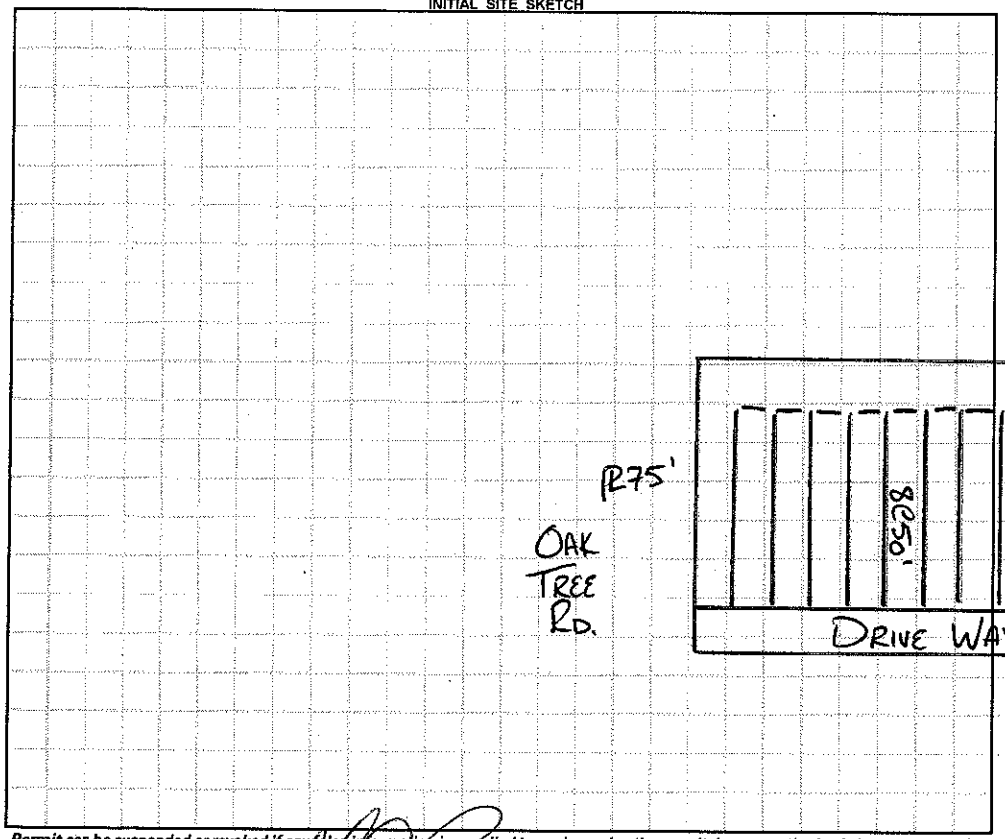

AS BUILT SKETCH

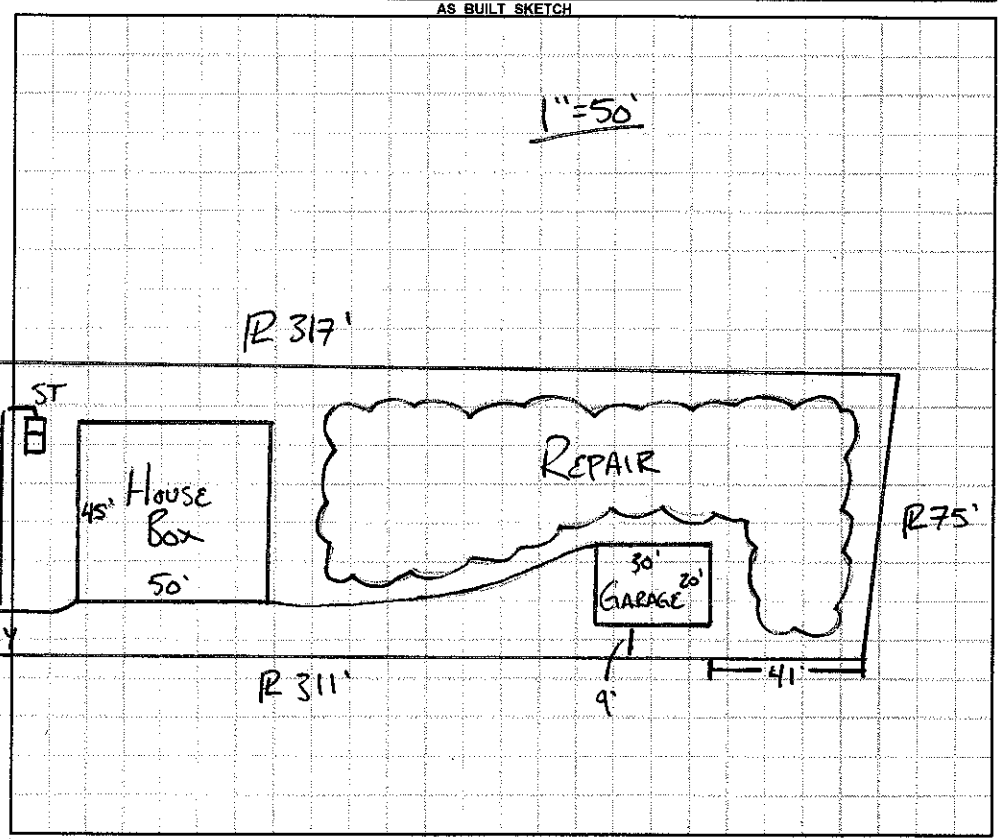

Permit can be suspended or revoked if any false information is supplied toward securing the permit / any unauthorized changes are made to the site / any unauthorized changes are made in the installation of the system. **CONTACT A LOCATOR SERVICE PRIOR TO ANY EXCAVATION**

☐ **IMPROVEMENT PERMIT** *with plat valid without expiration* ☐ **IMPROVEMENT PERMIT** *with site plan valid for 60 mos.* ☐ **AUTHORIZATION TO CONSTRUCT** *valid for period equal to IMPROVEMENT PERMIT--not to exceed 60 mo.*

Owner / Applicant Signature: ____ Date: 4/27/16 Installed by: ____

IMPROVEMENT PERMIT by: ____ Date: ____ OPERATION PERMIT by: ____ Date: ____

AUTHORIZATION TO CONSTRUCT by: ____ Date: ____ Existing System Inspected by: ____ Date: 4-7-16

Health Dept. Copy - WHITE Applicant (Final Approval) - YELLOW Applicant (Conditional Approval) - PINK