# IREDELL COUNTY HEALTH DEPARTMENT

STATESVILLE 704-878-5305 MOORESVILLE 704-664-5281

## IMPROVEMENT PERMIT / AUTHORIZATION TO CONSTRUCT / OPERATION PERMIT / EXISTING SYSTEM INSPECTION

PERMIT# 072440 PIN# 4637618164 DATE 3/17/98

OWNER OR CONTRACTOR RAY SHORT PHONE: Business Home 664-6761

ADDRESS 470 STUTTS RD MOORESVILLE NC 28115

LOCATION BRAWLEY SCHOOL - TR OAK TREE - TR HARBORCREST - 3RD ON LEFT

SUBDIVISION HARBORCREST BLOCK / SECTION — LOT 3 LOT AREA — SITE CLASS. PS DESIGN FLOW 360 GPD L.T.A.R. .36 GPD/FT =

Septic Tank: 1000 Gallons; STB 744 Date 6/11/98

Pump Tank: Gallons; PT Date

Pump Make: Model Serial No.

Nitrification Field: No Fields 1 Square Feet 900 Linear Feet 300

No Lines 5@60' Trench Width 36" Max Trench Bottom Depth 36" Gravel Depth N/A

☑ New System ☐ Repair System Type: I, II, III, IV, V, VI

System Description: GRAVITY CHAMBERED OR HDS

Repair System Description: GRAVITY PANEL

Maintenance Agreement Required: ☐ Yes ☑ No

☑ House/Mod. Home ☐ Mobile Home ☐ Business ☐ Other

No. Bedrooms 3 No. Bathrooms 2½ No. Employees


Water Supply: ☑ Individual ☐ Public ☐ Community

☐ Slab ☑ Crawl Space ☐ Basement w/plumbing ☐ Basement wo/plumbing


Comments:/Conditions:

Comments:/Conditions:

INITIAL SITE SKETCH 1"=40'

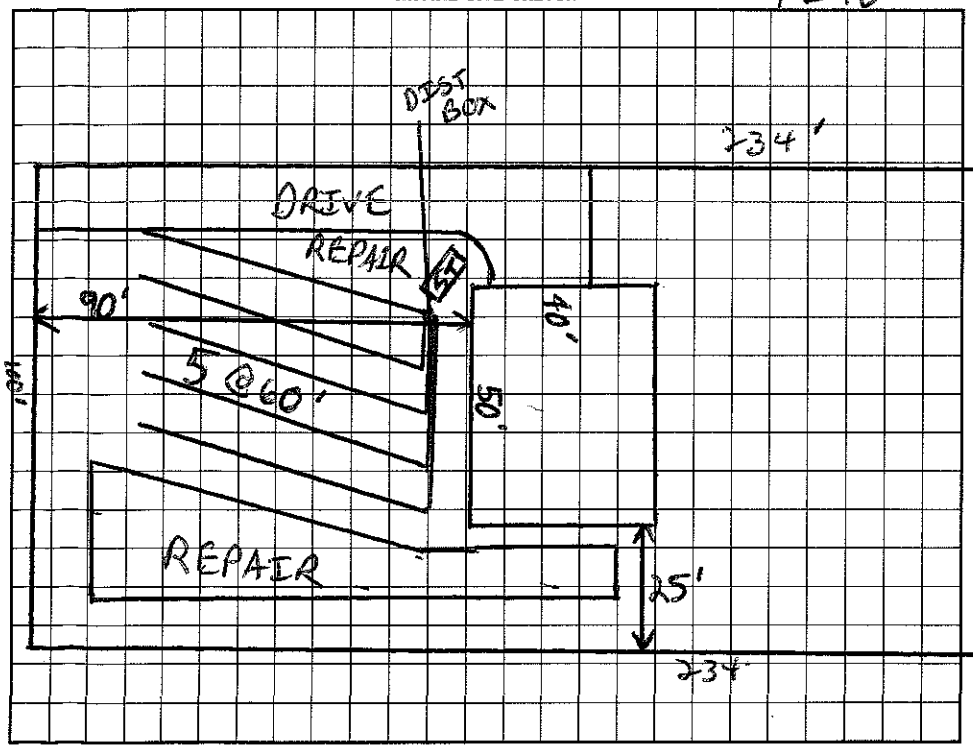


AS BUILT SKETCH

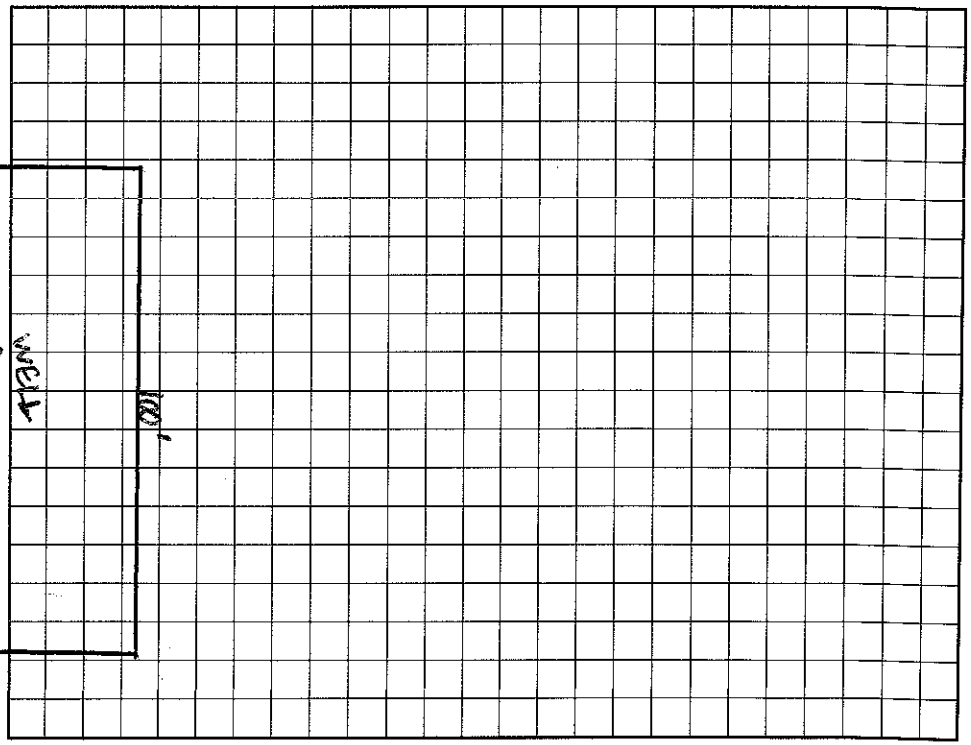


I understand that this permit can be suspended or revoked if any false information is supplied toward securing the permit/any unauthorized changes are made to the site/any unauthorized changes are made in the installation of the system. Improvement Permit with plat valid without expiration. Improvement Permit with site plan valid for sixty months. Authorization to Construct is valid for a period equal to that of Improvement Permit – not to exceed sixty months.

Signed: T. Ray Short Jr. date

Improvement Permit by: C. Bly Teem RS date 3/17/98

Authorization to Construct by: C. Bly Teem RS date 3/17/98

Installed by: FJ ERVIN

Operation Permit by: C. Bly Teem date 8/25/98

Existing System Inspection by: date

HEALTH DEPT. COPY: WHITE INSPECTION COPY (FINAL): GREEN OWNER COPY (FINAL): YELLOW INSPECTION COPY (INITIAL): PINK OWNER COPY (INITIAL): GOLD