4637-61-8264

IREDELL COUNTY HEALTH DEPARTMENT

STATESVILLE 704-878-5305 MOORESVILLE 704-664-5281

IMPROVEMENT PERMIT / CERTIFICATE OF COMPLETION / OPERATION PERMIT / EXISTING SYSTEM INSPECTIO.

PROPERTY DESCRIPTION NO. 21002 DATE May 22, '95 TAX MAP NO. part of 2K A 41A Watershed: ☑ Yes ☐ No

OWNER OR CONTRACTOR MT Investments PHONE: Business 664-6556 Home WSIV

ADDRESS PO Box 726, Mooresville

LOCATION Brawley School Road TR Oak Tree Rd. ~½ mile TR Harborcrest Lane 4th lot on left

SUBDIVISION Harborcrest BLOCK / SECTION LOT 4 LOT AREA ~25,000 ft² SITE CLASS. PS DESIGN FLOW 360gpd L.T.A.R. .3

Septic Tank: 1000 Gallons; STB 794 Date 9/8/95
Pump Tank: Gallons; PT Date
Pump Make: Model Serial No.
Nitrification Field: No Fields 1 Square Feet 1200 Linear Feet 400 (360)
No Lines 4 @ 100' Trench Width 36" Max Trench Bottom Depth 36" Gravel Depth 12"

☑ New System ☐ Repair System Type: I, II, III, IV, V, VI
System Description: gravity conventional
Repair System Description: grav. Infiltrator
Maintenance Agreement Required: ☐ Yes ☑ No

☑ House/Mod. Home No. Bedrooms 3
☐ Mobile Home No. Bathrooms 2½
☐ Business No. Employees
☐ Other

☐ Slab ☑ Crawl Space ☐ Basement w/plumbing ☐ Basement wo/plumbing


Water Supply: ☑ Individual ☐ Community ☐ Public

Comments: 5/24/95 OK to move house 10' closer to street ROW


Comments: 11-3-95 House not located where shown. Plumbing deep – house site cut and lowered – Infiltrator Laterals marked – Soil evaluated 6' deep & OK DHT

1"=50'

INITIAL SITE SKETCH

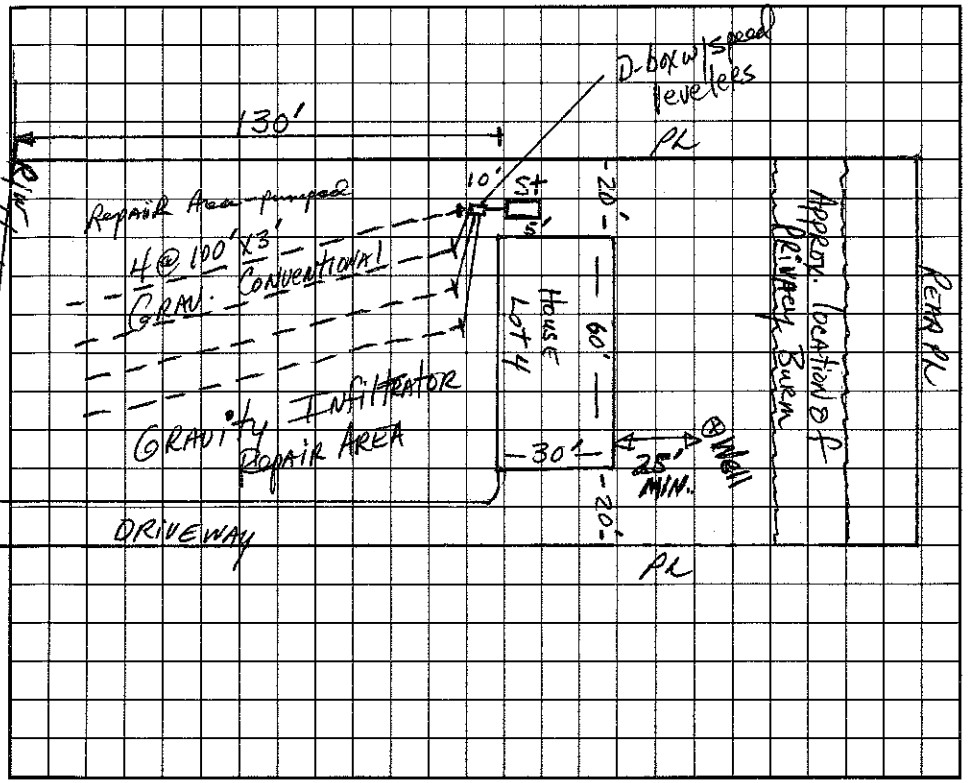

AS BUILT SKETCH

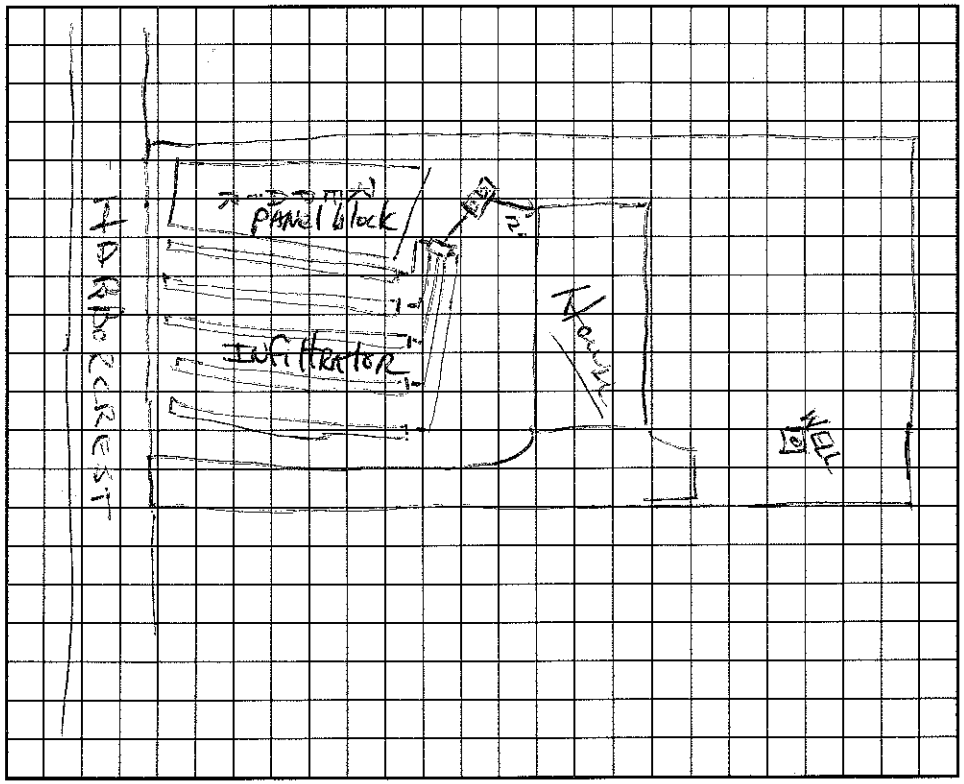

I understand that this permit can be suspended or revoked if any false information is supplied toward securing the permit/any unauthorized changes are made to the site/any unauthorized changes are made in the installation of the system. Improvement Permit is valid for 60 months from date of issuance.

Signed: Larry Thompson

Improvement Permit by: Jason Johnson RS date 5/22/95

Existing System Inspection by: date

Installed by: Barry Thompson

Certificate of Completion by: Wesley Sparks R.S. date 11/9/95

Operation Permit by: Wesley Sparks R.S. date 11/9/95

HEALTH DEPT. COPY: WHITE INSPECTION COPY (FINAL): GREEN OWNER COPY (FINAL): YELLOW INSPECTION COPY (INITIAL): PINK OWNER COPY (INITIAL): GOLD