IREDELL COUNTY HEALTH DEPARTMENT

STATESVILLE 704-878-5305 MOORESVILLE 704-664-5281

IMPROVEMENT PERMIT / AUTHORIZATION TO CONSTRUCT / OPERATION PERMIT / EXISTING SYSTEM INSPECTIO

PERMIT# 072442 PIN# 4637618364 DATE 4/30/98

OWNER OR CONTRACTOR RAY SHORT PHONE: Business Home

ADDRESS 470 STATTS RD - MOORESVILLE NC 28115

LOCATION BRAWLEY SCHOOL - TR OAKTREE - TR HARBORCREST - 5TH LOT ON LT

SUBDIVISION HARBORCREST BLOCK / SECTION LOT 5 LOT AREA SITE CLASS. RS DESIGN FLOW 360 GPD L.T.A.R. .30 GPD/FT²

Septic Tank: 1000 Gallons; STB 749 Date 12/11/68

Pump Tank: Gallons; PT Date

Pump Make: Model Serial No.

Nitrification Field: No Fields 1 Square Feet 400 Linear Feet 200

No Lines 4 @ 50' Trench Width 36" Max Trench Bottom Depth 36" Gravel Depth N/A

☑ New System ☐ Repair System Type: I, II, (III) IV, V, VI

System Description: GRAVITY PANEL

Repair System Description: SAME

Maintenance Agreement Required: ☐ Yes ☑ No

☑ House/Mod. Home No. Bedrooms 3

☐ Mobile Home No. Bathrooms 2

☐ Business No. Employees

☐ Other


☐ Slab ☑ Crawl Space ☐ Basement w/plumbing ☐ Basement wo/plumbing

Water Supply: ☑ Individual ☐ Public ☐ Community

Comments:/Conditions: PLUMBING IS TO BE STUBBED OUT ON HIGH END OF HOUSE WHERE TANK IS LOCATED OR PERMIT WILL BE VOIDED.

Comments:/Conditions:

INITIAL SITE SKETCH 1"=50'

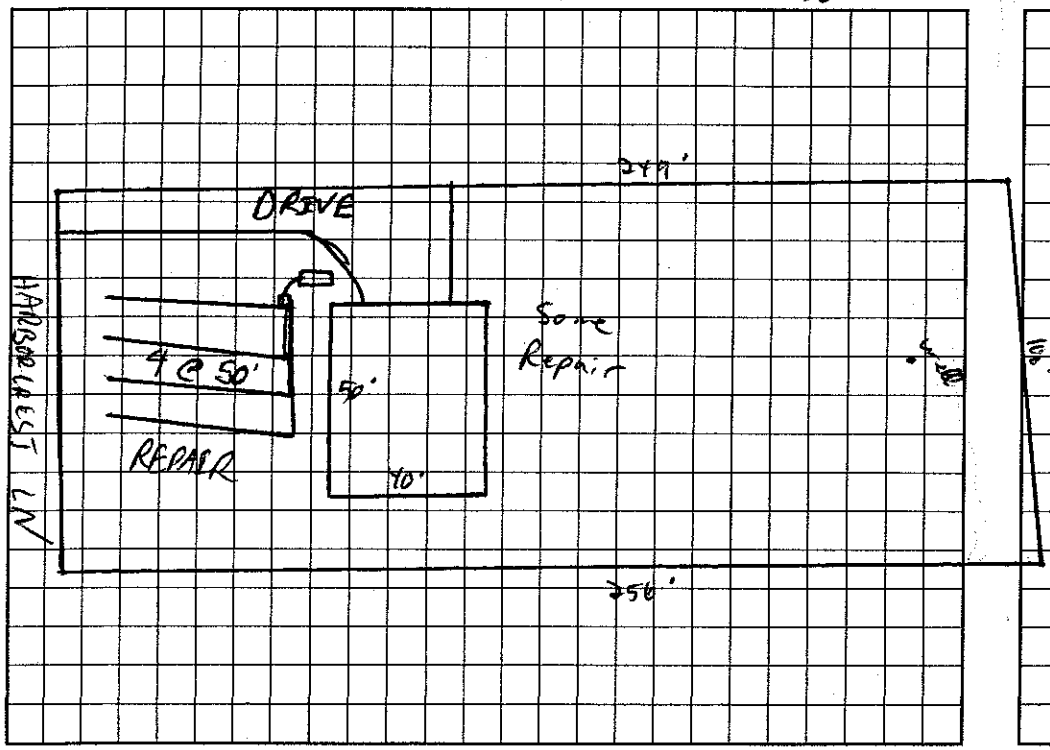

AS BUILT SKETCH

I understand that this permit can be suspended or revoked if any false information is supplied toward securing the permit/any unauthorized changes are made to the site/any unauthorized changes are made in the install tion of the system. Improvement Permit with plat valid without expiration. Improvement Permit with site plan valid for sixty months. Authorization to Construct is valid for a period equal to that of Improvement Permit – n to exceed sixty months.

Signed: W. Ray Short date 5/1/98 Installed by: FJ EVANS

Improvement Permit by: C. B. Reeves RS date 4/30/98 Operation Permit by: C. B. Reeves date 11/16/98

Authorization to Construct by: C. B. Reeves RS date 4/30/98 Existing System Inspection by: date

HEALTH DEPT. COPY: WHITE INSPECTION COPY (FINAL): GREEN OWNER COPY (FINAL): YELLOW INSPECTION COPY (INITIAL): PINK OWNER COPY (INITIAL): GOLD