IREDELL COUNTY HEALTH DEPARTMENT

STATESVILLE 704-878-5305 MOORESVILLE 704-664-5281

IMPROVEMENT PERMIT / CERTIFICATE OF COMPLETION / OPERATION PERMIT / EXISTING SYSTEM INSPECTION

PROPERTY DESCRIPTION NO. 21011 DATE May 23, '95 TAX MAP NO. part of 2 & 4 41A 4637618564 Watershed: ☑ Yes ☐ No ws4

OWNER OR CONTRACTOR MT Investments PHONE: Business 664-6556 Home

ADDRESS PO Box 726 Mooresville, NC

LOCATION Brawley Sch Rd. to Oak Tree Rd. TR Harbortrest Lane 7th lot on left

SUBDIVISION Harbortrest BLOCK / SECTION LOT 7 LOT AREA ~25,000 ft² SITE CLASS. 5 per R56 DESIGN FLOW 360 gpd L.T.A.R. .3

Septic Tank: 1000 Gallons; STB 825 Date 5/11/96

Pump Tank: 1000 Gallons; PT 47 Date 5/20/96

Pump Make: Hurd Model 3886 D. Serial No. ?

Nitrification Field: No Fields 1 Square Feet 900 Linear Feet 300

No Lines 4@75 Trench Width 36" Max Trench Bottom Depth 36" Gravel Depth NA

☑ New System ☐ Repair System Type: I, II, III, IV, V, VI

System Description: pump/tank/IAF/Heater

Repair System Description: same

Maintenance Agreement Required: ☐ Yes ☑ No

☑ House/Mod. Home No. Bedrooms 3

☐ Mobile Home No. Bathrooms 2.5

☐ Business No. Employees

☐ Other

☐ Slab ☑ Crawl Space ☐ Basement w/plumbing ☐ Basement wo/plumbing


Water Supply: ☑ Individual ☐ Community ☐ Public

Comments: SEE ME for details on pressure manifold—ERH

Comments:

INITIAL SITE SKETCH

1" = 50'

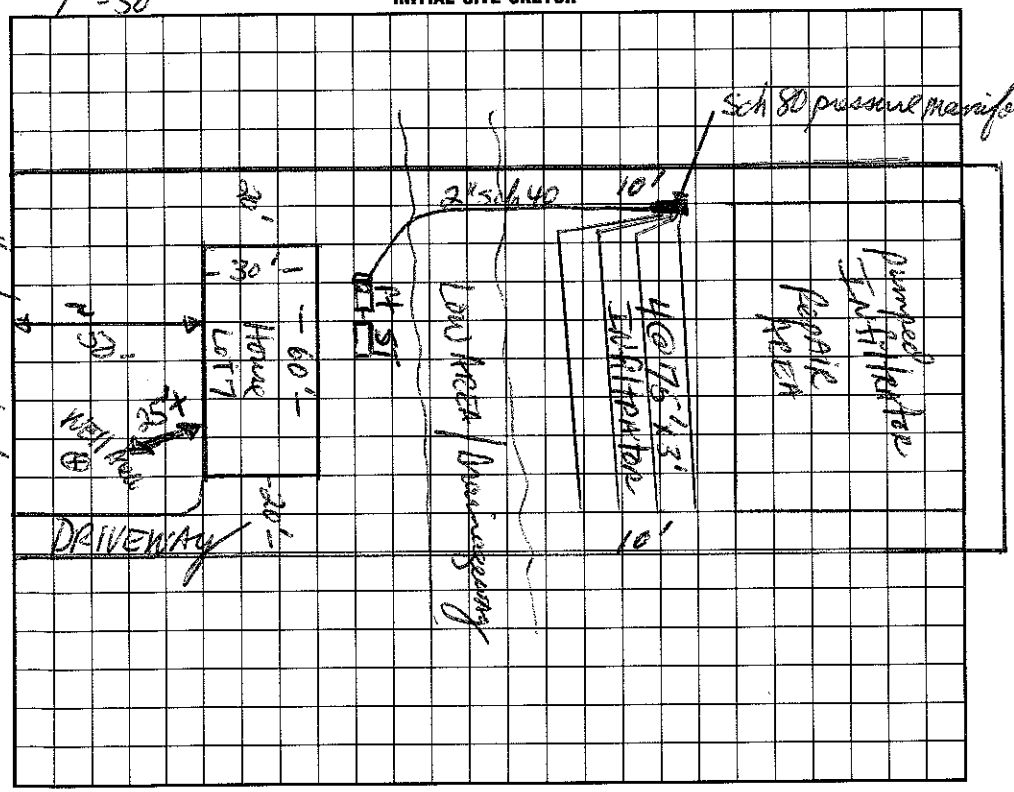

AS BUILT SKETCH

I understand that this permit can be suspended or revoked if any false information is supplied toward securing the permit/any unauthorized changes are made to the site/any unauthorized changes are made in the installation of the system. Improvement Permit is valid for 60 months from date of issuance.

Signed:

Improvement Permit by: [signature], RS date 5/23/95

Existing System Inspection by: date

Installed by: Thompson Enthusiasts

Certificate of Completion by: date

Operation Permit by: Wesley Sparks R.S. date 7/11/96

HEALTH DEPT. COPY: WHITE INSPECTION COPY (FINAL): GREEN OWNER COPY (FINAL): YELLOW INSPECTION COPY (INITIAL): PINK OWNER COPY (INITIAL): GOLD