4637-61-8763

IREDELL COUNTY HEALTH DEPARTMENT

STATESVILLE 704-878-5305 MOORESVILLE 704-664-5281

IMPROVEMENT PERMIT / CERTIFICATE OF COMPLETION / OPERATION PERMIT / EXISTING SYSTEM INSPECTIO

PROPERTY DESCRIPTION NO. 21013 DATE May 23, '95 TAX MAP NO. part of 2KA41A Watershed: ☑ Yes ☐ No

OWNER OR CONTRACTOR MT Investments PHONE: Business 664-6532 Home 4054

ADDRESS PO Box 726, Mooresville NC

LOCATION Highway 5 to RD, TR Oak Tree Rd, TR Harborcrest Lane 9th lot on left

SUBDIVISION Harborcrest BLOCK / SECTION _____ LOT 9 LOT AREA ~25,000 ft² SITE CLASS. Bp-1996 DESIGN FLOW 360gpd L.T.A.R. .3

Septic Tank: 1000 Gallons; STB 794 Date 10/16/95

Pump Tank: _____ Gallons; PT _____ Date _____

Pump Make: _____ Model _____ Serial No. _____

Nitrification Field: No Fields 1 Square Feet 900 Linear Feet 300

No Lines 4@75' Trench Width 36" Max Trench Bottom Depth 36" Gravel Depth N/A

☑ New System ☐ Repair System Type: I, II, III, IV, V, VI

System Description: gravity Infi Trench

Repair System Description: grade PP BPS

Maintenance Agreement Required: ☐ Yes ☑ No

☐ House/Mod. Home No. Bedrooms 3

☐ Mobile Home No. Bathrooms 2.5

☐ Business No. Employees _____

☐ Other _____

☐ Slab ☑ Crawl Space ☐ Basement w/plumbing ☐ Basement wo/plumbing


Water Supply: ☑ Individual ☐ Community ☐ Public

Comments:


Comments: As System Layout approved by DRH.

INITIAL SITE SKETCH

1"=50'

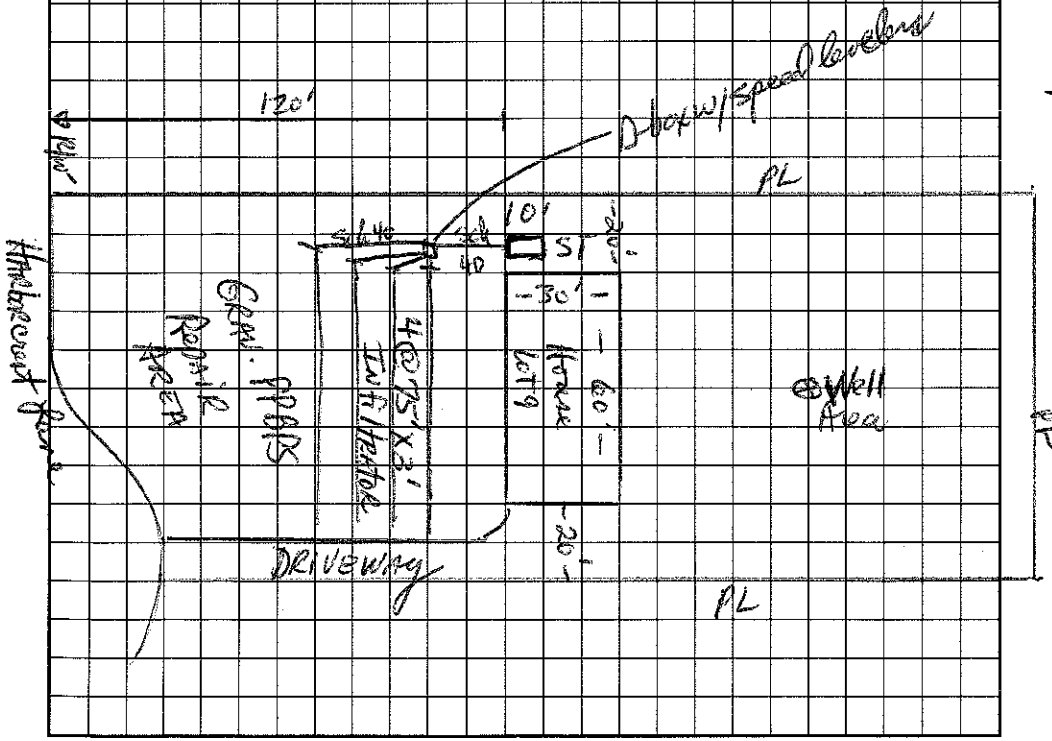

AS BUILT SKETCH

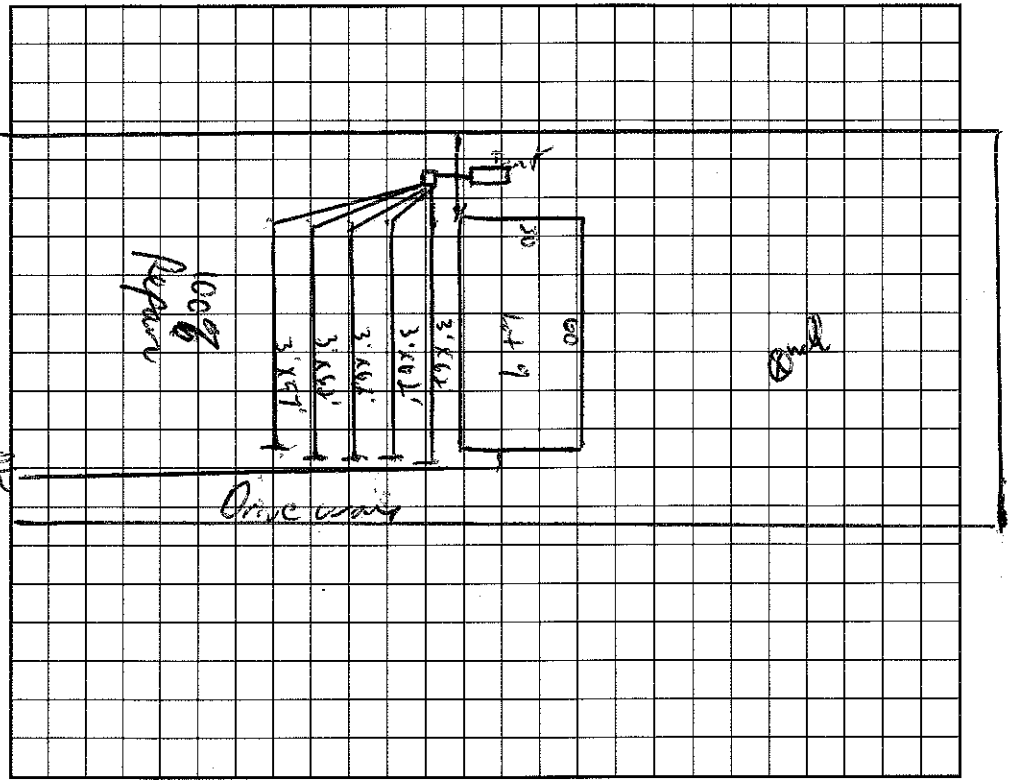

I understand that this permit can be suspended or revoked if any false information is supplied toward securing the permit/any unauthorized changes are made to the site/any unauthorized changes are made in the installation of the system. Improvement Permit is valid for 60 months from date of issuance.

Signed: _____

Improvement Permit by: _____ date 5/23/95

Existing System Inspection by: _____ date _____

Installed by: _____

Certificate of Completion by: _____ date 12/4/95

Operation Permit by: _____ date _____

HEALTH DEPT. COPY: WHITE INSPECTION COPY (FINAL): GREEN OWNER COPY (FINAL): YELLOW INSPECTION COPY (INITIAL): PINK OWNER COPY (INITIAL): GOLD