IREDELL COUNTY HEALTH DEPARTMENT

STATESVILLE 704-878-5305 MOORESVILLE 704-664-5281

IMPROVEMENT PERMIT / ~~CERTIFICATE OF COMPLETION~~ / OPERATION PERMIT / EXISTING SYSTEM INSPECTION

2500 SQ FT HOUSE TO CONSTRUCT

PROPERTY DESCRIPTION NO. 069945 DATE 10/31/97 TAX MAP NO. ~~463 7094168~~ 4606434744 7 Watershed: ☑ Yes ☐ No

OWNER OR CONTRACTOR RICHARD McGUIRE PHONE: Business _____ Home 932-6258

ADDRESS 7725 HOWARD AVE. KANNAPOLIS NC 28081

LOCATION RIVER HWY - TL DOOLIE RD - LINEBERGER - AT END

SUBDIVISION WILKINSON BLOCK / SECTION — LOT 2 LOT AREA .53AC SITE CLASS. PS DESIGN FLOW 240 GPD L.T.A.R. 3 @ 00/FT

Septic Tank: 1000 Gallons; STB 825 Date 11/21/97

Pump Tank: _____ Gallons; PT _____ Date _____

Pump Make: _____ Model _____ Serial No. _____

Nitrification Field: No Fields 1 Square Feet 810 Linear Feet 267'

No Lines 2 @ 133' Trench Width 36" Max Trench Bottom Depth 36" Gravel Depth 12"

☑ New System ☐ Repair System Type: I, (II), III, IV, V, VI

System Description: GRAVITY CONVENTIONAL

Repair System Description: PUMP PANEL

Maintenance Agreement Required: ☐ Yes ☑ No

☑ House/Mod. Home No. Bedrooms 2

☐ Mobile Home No. Bathrooms 2

☐ Business No. Employees ____

☐ Other _____


☐ Slab ☑ Crawl Space ☐ Basement w/plumbing ☐ Basement wo/plumbing

Water Supply: ☑ Individual ☐ Community ☐ Public

Comments:

Comments:

INITIAL SITE SKETCH

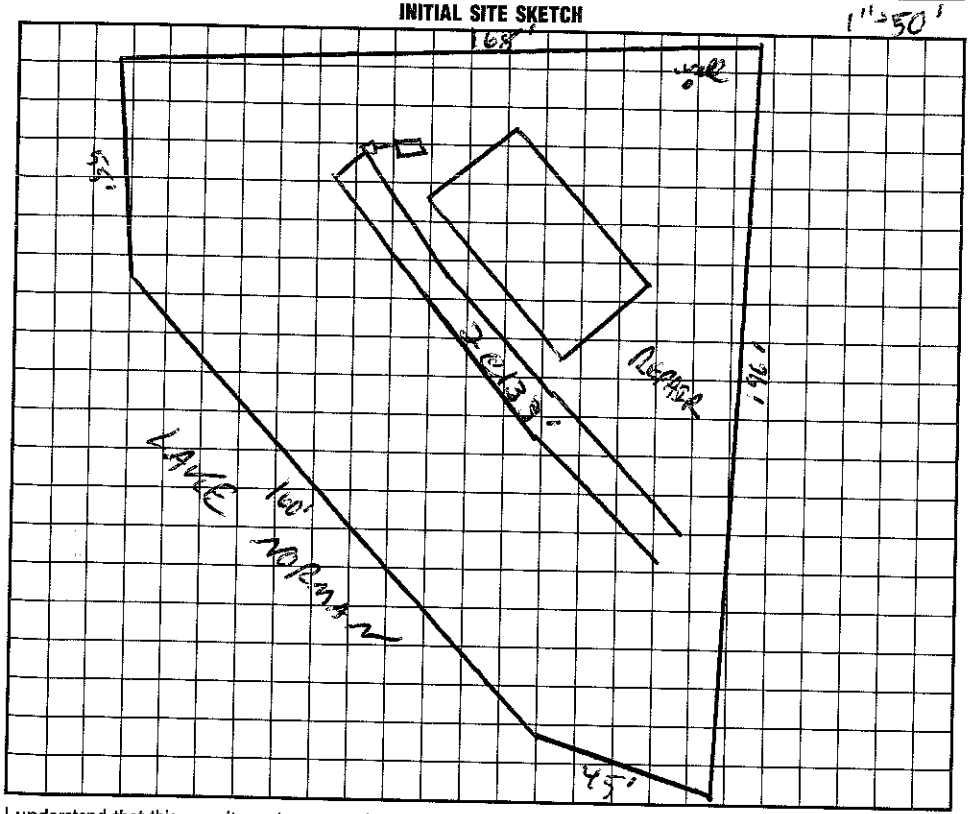

AS BUILT SKETCH

I understand that this permit can be suspended or revoked if any false information is supplied toward securing the permit/any unauthorized changes are made to the site/any unauthorized changes are made in the installation of the system. Improvement Permit is valid for 60 months from date of issuance.

Signed: Richard E McGuire

Improvement Permit by: C. Ray Teem RS date 10/31/97

~~Authorization to Existing System Inspection by:~~ C. Ray Teem RS date 10/31/97 CONSTRUCT

Installed by: BOSTIAN

Certificate of Completion by: _____ date _____

Operation Permit by: C. Ray Teem date 1/30/98

HEALTH DEPT. COPY: WHITE INSPECTION COPY (FINAL): GREEN OWNER COPY (FINAL): YELLOW INSPECTION COPY (INITIAL): PINK OWNER COPY (INITIAL): GOLD