IREDELL COUNTY HEALTH DEPARTMENT

STATESVILLE 704-878-5305 MOORESVILLE 704-664-5281

IMPROVEMENT PERMIT / AUTHORIZATION TO CONSTRUCT / OPERATION PERMIT / EXISTING SYSTEM INSPECTION

PERMIT# 13592 20 PIN# 4637664638 DATE 9/27/06

OWNER OR APPLICANT MAC DUTCH INC PHONE: Business Home 704-892-5988

ADDRESS 102 Harbourgate Ct Cornelius NC 28031

LOCATION Hwy 150 W, L on Kendra Dr, Lot on Rt on cul-de-sac

SUBDIVISION Double Meadows BLOCK / SECTION LOT 23 LOT AREA .67 Ac SITE CLASS. PS DESIGN FLOW 480gpd L.T.A.R. .3gpd/Ac

Septic Tank: 1000+ Gallons; STB 1620 Date 11/17/06

Pump Tank: Gallons; PT Date

Pump Make: Model Serial No.

Nitrification Field: No Fields 1 Square Feet 1290 Linear Feet 400

No Lines 5 Trench Width 36 inch Max Trench Bottom Depth 36 inch Gravel Depth N/A

[X] New System [ ] Repair [ ] Expansion System Type: [ ] I [X] II [ ] III [ ] IV [ ] V [ ] VI

System Description: Gravity-2 Bed

Repair System Description: PPBPS

Maintenance Agreement Required: [ ] Yes [X] No

[X] House/Mod. Home No. Bedrooms 4

[ ] Mobile Home No. Persons

[ ] Business No. Employees

[ ] Other


Water Supply: [ ] Individual [ ] Public [X] Community

[X] Gravity [ ] Pressure [ ] Slab [X] Crawl Space [ ] Basement w/plumbing [ ] Basement wo/plumbing

Comments/Conditions: 5 Drain lines at different lengths fed by drop boxes, follow contours


Stay 10ft off Prop lines - Clear/Remove High Bush Areas

INITIAL SITE SKETCH

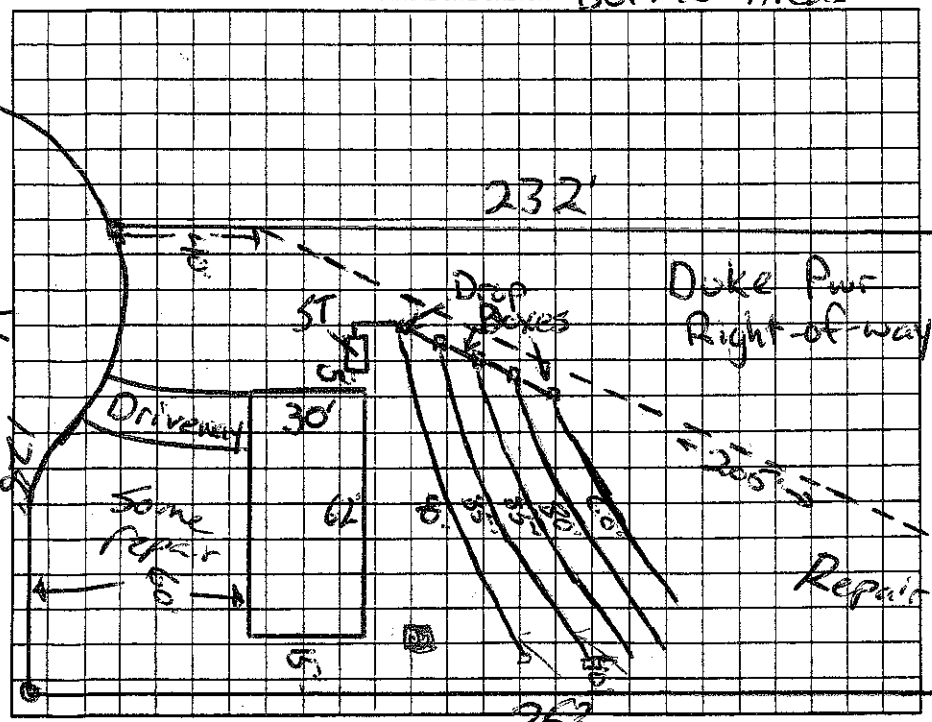

Comments/Conditions: 5/8/07 Reviewed Floor plans & Site plan in compliance with original permit

AS BUILT SKETCH

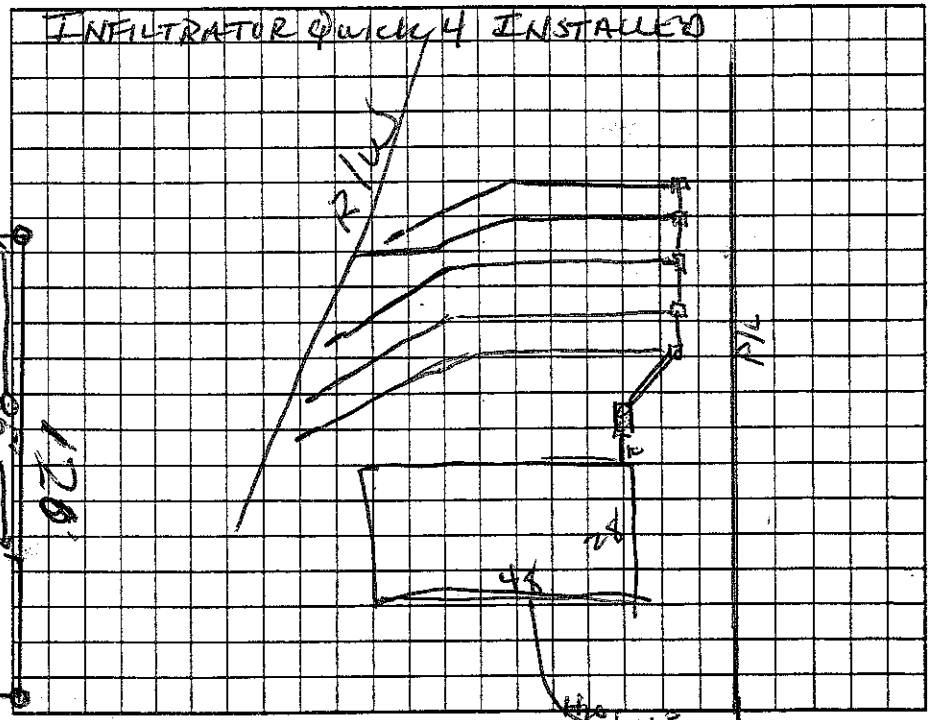

Permit can be suspended or revoked if any false information is supplied toward securing the permit/any unauthorized changes are made to the site/any unauthorized changes are made in the installation of the system. Improvement Permit with plat valid without expiration [ ] Improvement Permit with site plan valid for sixty months [X] Authorization to Construct is valid for a period equal to that of Improvement Permit – not to exceed sixty months.

Signed: date 9-27-06 Installed by: Sonny Reavis

Improvement Permit by: date 9/27/06 Operation Permit by: Wesley Sparks R.S. date 7/3/07

Authorization to Construct by: date 5/8/07 Existing System Inspection by: date

HEALTH DEPT. COPY: WHITE OWNER COPY (FINAL): YELLOW OWNER COPY (INITIAL): PINK