IREDELL COUNTY HEALTH DEPARTMENT

STATESVILLE 704-878-5305 3500 gal MOORESVILLE 704-664-5281

IMPROVEMENT PERMIT / AUTHORIZATION TO CONSTRUCT / OPERATION PERMIT / EXISTING SYSTEM INSPECTION

PERMIT# 123869 PIN# 4637-66-9965 DATE 3/14/05

OWNER OR CONTRACTOR ~~Spear Builders, Inc.~~ / Regent Homes PHONE: Business _____ Home _____

ADDRESS 192 Wild Wood Cove Dr. Mooresville NC 28117

LOCATION HWY 150 W TL Kendra, on Rt

SUBDIVISION Dalie Meadows BLOCK / SECTION _____ LOT 15 LOT AREA 25,008 Ft² SITE CLASS. PS DESIGN FLOW 360 L.T.A.R. 0.25

Septic Tank: 1000 Gallons; STB 1012 Date 1/2/05

Pump Tank: 1000 Gallons; PT 17 Date 4/23/05

Pump Make: Goulds Model EP0411A Serial No. _____

Nitrification Field: No Fields 1 Square Feet 720 Linear Feet 240

No Lines 4@60' Trench Width 24" Bed Max Trench Bottom Depth 36" Gravel Depth —

☒ New System ☐ Repair System Type: I, II, III, (IV), V, VI

System Description: LP Panel Block

Repair System Description: same

Maintenance Agreement Required: ☒ Yes ☐ No

☒ House/Mod. Home No. Bedrooms 3

☐ Mobile Home No. Bathrooms ____

☐ Business No. Employees ____

☐ Other _____


☐ Slab ☒ Crawl Space ☐ Basement w/plumbing ☐ Basement wo/plumbing

Water Supply: ☐ Individual ☐ Public ☒ Community


Comments:/Conditions: 36" BR 9FOC

Comments:/Conditions:

INITIAL SITE SKETCH

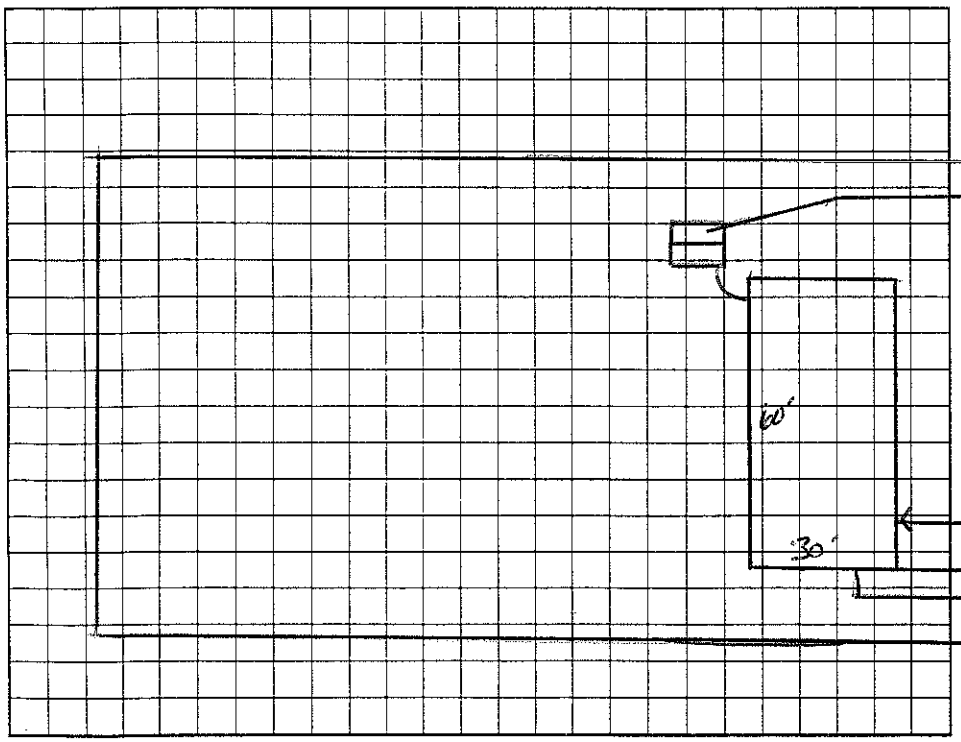

AS BUILT SKETCH

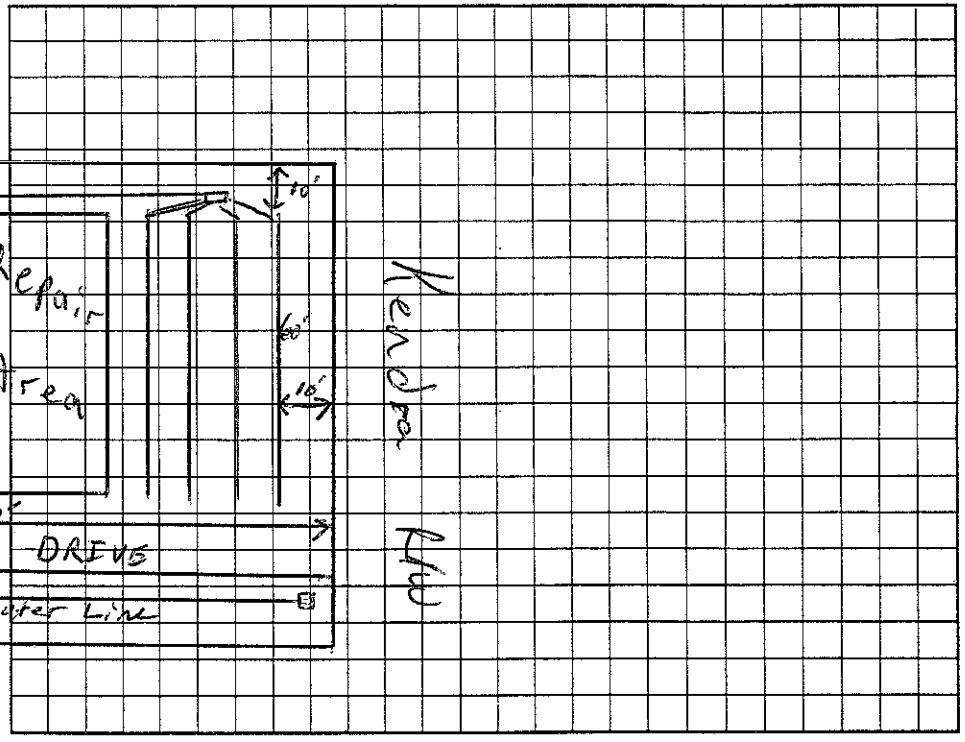

Permit can be suspended or revoked if any false information is supplied toward securing the permit/any unauthorized changes are made to the site/any unauthorized changes are made in the installation of the system. Improvement Permit with plat valid without expiration. Improvement Permit with site plan valid for sixty months. Authorization to Construct is valid for a period equal to that of Improvement Permit – not to exceed sixty months.

Signed: _____ date 3-14-05 Installed by: A-1 Backhoe

Improvement Permit by: RS date 3/14/05 Operation Permit by: RS date 8/4/05

Authorization to Construct by: RS date 3/14/05 Existing System Inspection by: _____ date _____

HEALTH DEPT. COPY: WHITE OWNER COPY (FINAL): YELLOW OWNER COPY (INITIAL): PINK