IREDELL COUNTY HEALTH DEPARTMENT

STATESVILLE 704-878-5305 MOORESVILLE 704-664-5281

IMPROVEMENT PERMIT / AUTHORIZATION TO CONSTRUCT / OPERATION PERMIT / EXISTING SYSTEM INSPECTION

PERMIT# 23539 PIN# 2P-D-7 PIN# 4637-67-9892 DATE 5/1/98

OWNER OR CONTRACTOR Rob + JILDA RAMSAY PHONE: Business 598-5800 Home 662-3898

ADDRESS 137 McAdam Dr. Mooresville, NC. 28115

LOCATION 150 W TL Kendra Dr. to 7th lot on (R)

SUBDIVISION Doolie Meadows BLOCK / SECTION ____ LOT 7 LOT AREA ____ SITE CLASS. PS DESIGN FLOW 360 L.T.A.R. .3

Septic Tank: 1000 Gallons; STB 825 Date 2/1/98
Pump Tank: ____ Gallons; PT ____ Date ____
Pump Make: ____ Model ____ Serial No. ____
Nitrification Field: No Fields 1 Square Feet 900 Linear Feet 300+
No Lines 5 Trench Width 36" Max Trench Bottom Depth 36" Gravel Depth SAND

[X] New System [ ] Repair System Type: I, II, (III) IV, V, VI
System Description: GR - CH PLASTIC
Repair System Description: SAME
Maintenance Agreement Required: [ ] Yes [X] No

[X] House/Mod. Home No. Bedrooms 3
[ ] Mobile Home No. Bathrooms 2.5
[ ] Business No. Employees ____
[ ] Other ____


[ ] Slab [X] Crawl Space [ ] Basement w/plumbing [ ] Basement wo/plumbing

Water Supply:
[ ] Individual
[ ] Public
[X] Community


Comments:/Conditions: + 25% Reduction for Ch. Plastic use -

Comments:/Conditions:

INITIAL SITE SKETCH

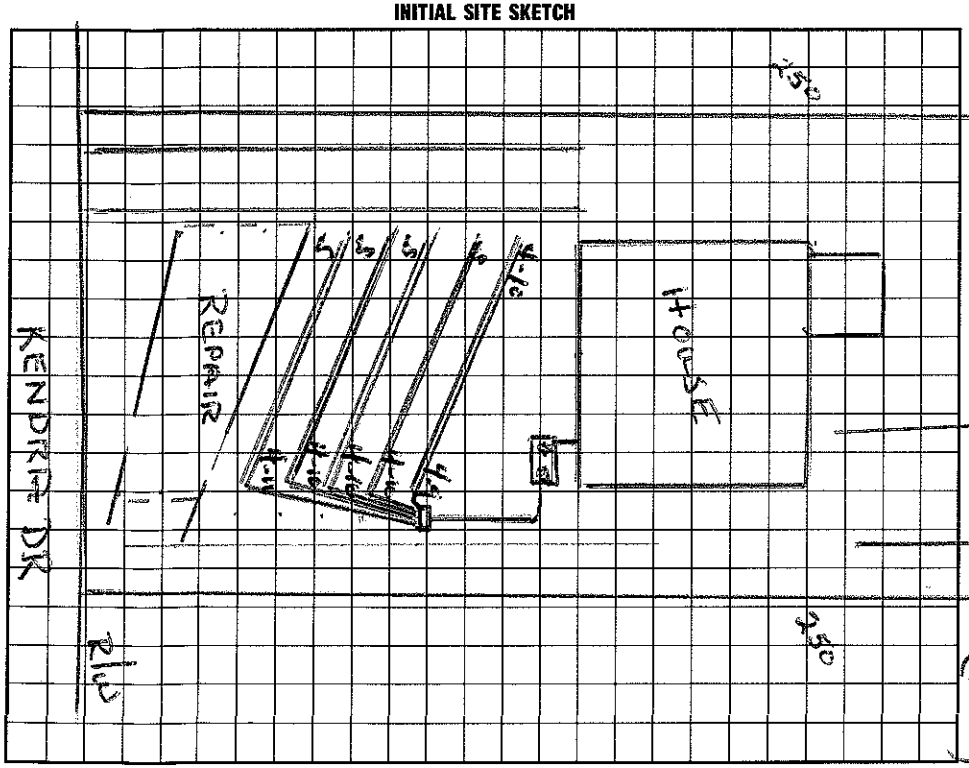

AS BUILT SKETCH

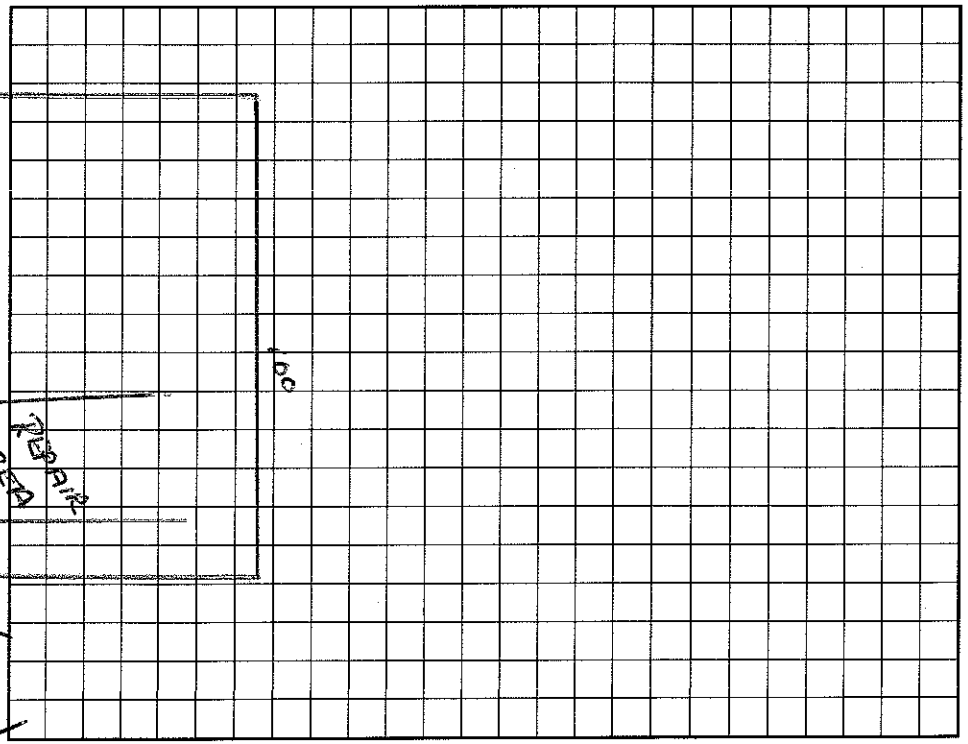

I understand that this permit can be suspended or revoked if any false information is supplied toward securing the permit/any unauthorized changes are made to the site/any unauthorized changes are made in the installation of the system. Improvement Permit with plat valid without expiration. Improvement Permit with site plan valid for sixty months. Authorization to Construct is valid for a period equal to that of Improvement Permit – not to exceed sixty months.

Signed: ____ date ____

Improvement Permit by: Wesley Sparks RS. date 5/1/98

Authorization to Construct by: Wesley Sparks RS date 5/1/98

Installed by: Chris Kamianka

Operation Permit by: Wesley Sparks RS. date 5/4/98

Existing System Inspection by: Wesley Sparks RS date 5/4/98

HEALTH DEPT. COPY: WHITE INSPECTION COPY (FINAL): GREEN OWNER COPY (FINAL): YELLOW INSPECTION COPY (INITIAL): PINK OWNER COPY (INITIAL): GOLD