IREDELL COUNTY HEALTH DEPARTMENT

↑ AUTHORIZATION TO CONSTRUCT

STATESVILLE 704-878-5305 MOORESVILLE 704-664-5281

IMPROVEMENT PERMIT / ~~CERTIFICATE OF COMPLETION~~ / OPERATION PERMIT / EXISTING SYSTEM INSPECTION

PROPERTY DESCRIPTION NO. 23538 DATE 07/1/97 TAX MAP NO. 2P-D-6

OWNER OR CONTRACTOR PERRY JENKENS Watershed: ☑ Yes ☐ No

ADDRESS 2141 OLD MTN. RD. 28677 PHONE: Business ANH 4637-67-9992 Home 872-0921

LOCATION HWY 150 W - TL KENDRA RD - 6TH LOT ON RIGHT

SUBDIVISION DIXIE MEADOWS BLOCK / SECTION ____ LOT 6 LOT AREA 25,004 SITE CLASS. RS DESIGN FLOW 360 GPD L.T.A.R. .36 IP-T

Septic Tank: 1000 Gallons; STB 1012 Date 6/17/97

Pump Tank: ____ Gallons; PT ____ Date ____

Pump Make: ____ Model ____ Serial No. ____

Nitrification Field: No Fields 1 Square Feet 900 Linear Feet 300

No Lines 4 @ 75' Trench Width 36" Max Trench Bottom Depth 36" Gravel Depth N/A

☑ New System ☐ Repair System Type: I, II, III, IV, V, VI

System Description: GRAVITY CHAMBERED OR SIMILAR

Repair System Description: PUMP CHAMBERED OR SIMILAR

Maintenance Agreement Required: ☐ Yes ☑ No

☑ House/Mod. Home No. Bedrooms 3

☐ Mobile Home No. Bathrooms 2

☐ Business No. Employees ____

☐ Other ____


☐ Slab ☑ Crawl Space ☐ Basement w/plumbing ☐ Basement wo/plumbing

Water Supply: ☐ Individual ☑ Community ☐ Public


Comments:

Comments:

INITIAL SITE SKETCH 1" = 40'

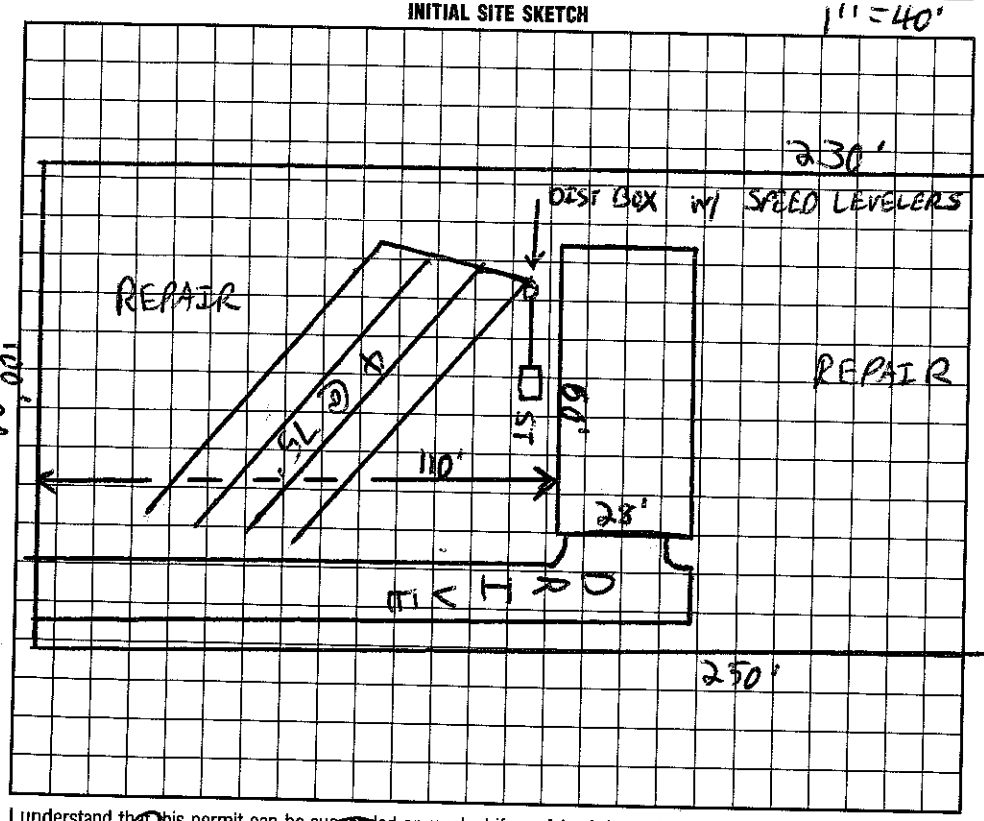

AS BUILT SKETCH

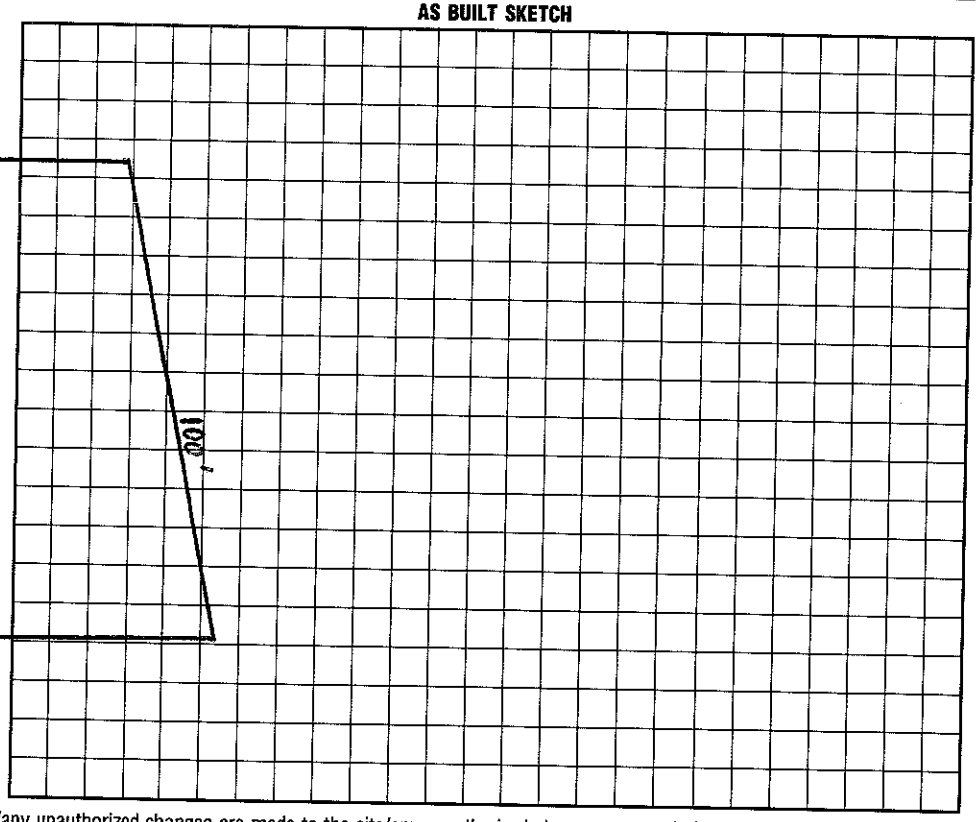

I understand that this permit can be suspended or revoked if any false information is supplied toward securing the permit/any unauthorized changes are made to the site/any unauthorized changes are made in the installation of the system. Improvement Permit is valid for 60 months from date of issuance.

Signed: Perry W Jenkens

Improvement Permit by: C. Ray Keen date 7/1/97

AUTHORIZATION TO CONSTRUCT

~~Existing System Inspection by:~~ C. Ray Keen date 7/1/97

Installed by: Tommy Frye

Certificate of Completion by: Wesley Sparks RS. date 8/26/97

Operation Permit by: Wesley Sparks RS. date 8/26/97

HEALTH DEPT. COPY: WHITE INSPECTION COPY (FINAL): GREEN OWNER COPY (FINAL): YELLOW INSPECTION COPY (INITIAL): PINK OWNER COPY (INITIAL): GOLD