IREDELL COUNTY HEALTH DEPARTMENT

AUTHORIZATION TO CONSTRUCT

STATESVILLE 704-878-5305 MOORESVILLE 704-664-5281

IMPROVEMENT PERMIT / ~~CERTIFICATE OF COMPLETION~~ / OPERATION PERMIT / EXISTING SYSTEM INSPECTION

PROPERTY DESCRIPTION NO. 23536 DATE 7/1/97 TAX MAP NO. 2P-D-4 Watershed: ☐ Yes ☐ No

OWNER OR CONTRACTOR PERRY W JENKINS ~~PHONE: Business~~ PHH 4637-68-9192 Home 872-0921

ADDRESS 2144 OLD MT. RD - STATESVILLE NC 28677

LOCATION SR 1500 W - TL KENORA DRIVE - 4TH LOT ON RT

SUBDIVISION DOOLIE MEADOWS BLOCK / SECTION _____ LOT 4 LOT AREA 24,613 ft² SITE CLASS. RS DESIGN FLOW 360 L.T.A.R. .369/FT²

Septic Tank: 1000 Gallons; STB 1012 Date 6/17/97

Pump Tank: _____ Gallons; PT _____ Date _____

Pump Make: _____ Model _____ Serial No. _____

Nitrification Field: No Fields 1 Square Feet 900 Linear Feet 300

No Lines 4 @ 75' Trench Width 36" Max Trench Bottom Depth 36" Gravel Depth N/A

☑ New System ☐ Repair System Type: I, II, III, IV, V, VI

System Description: GRAVITY CHAMBERED OR SIMILAR

Repair System Description: SAME

Maintenance Agreement Required: ☐ Yes ☑ No

☑ House/Mod. Home No. Bedrooms 3

☐ Mobile Home No. Bathrooms 2

☐ Business No. Employees _____

☐ Other _____

☐ Slab ☑ Crawl Space ☐ Basement w/plumbing ☐ Basement wo/plumbing


Water Supply:
☐ Individual
☑ Community
☐ Public

Comments:


Comments:

INITIAL SITE SKETCH

1" = 40'

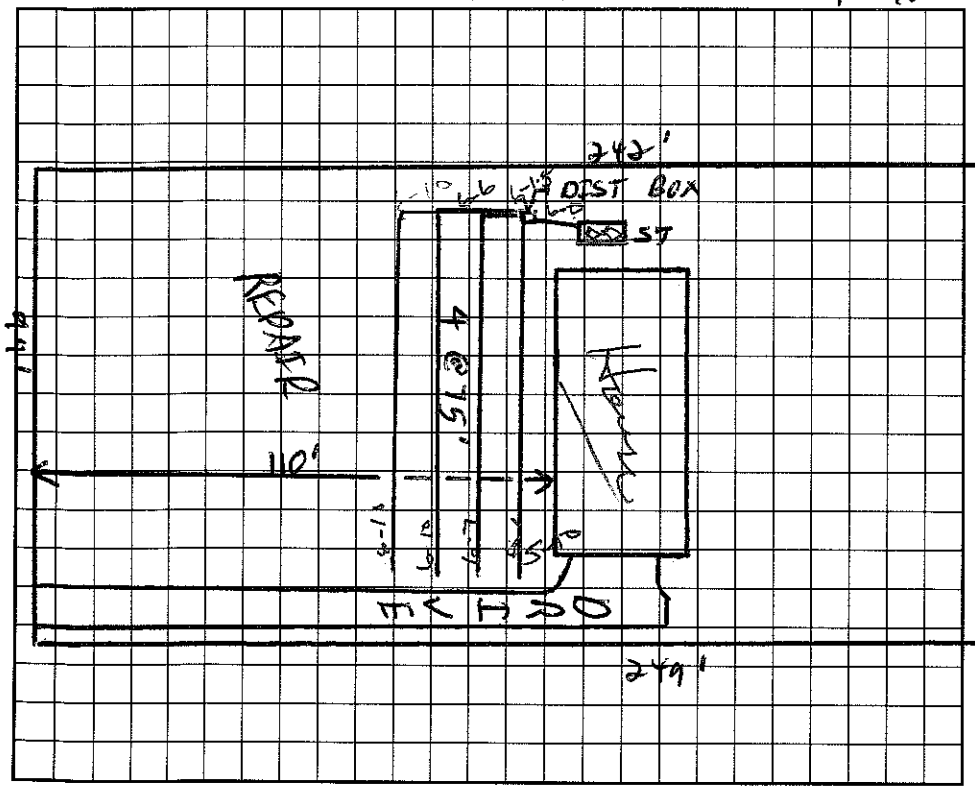

AS BUILT SKETCH

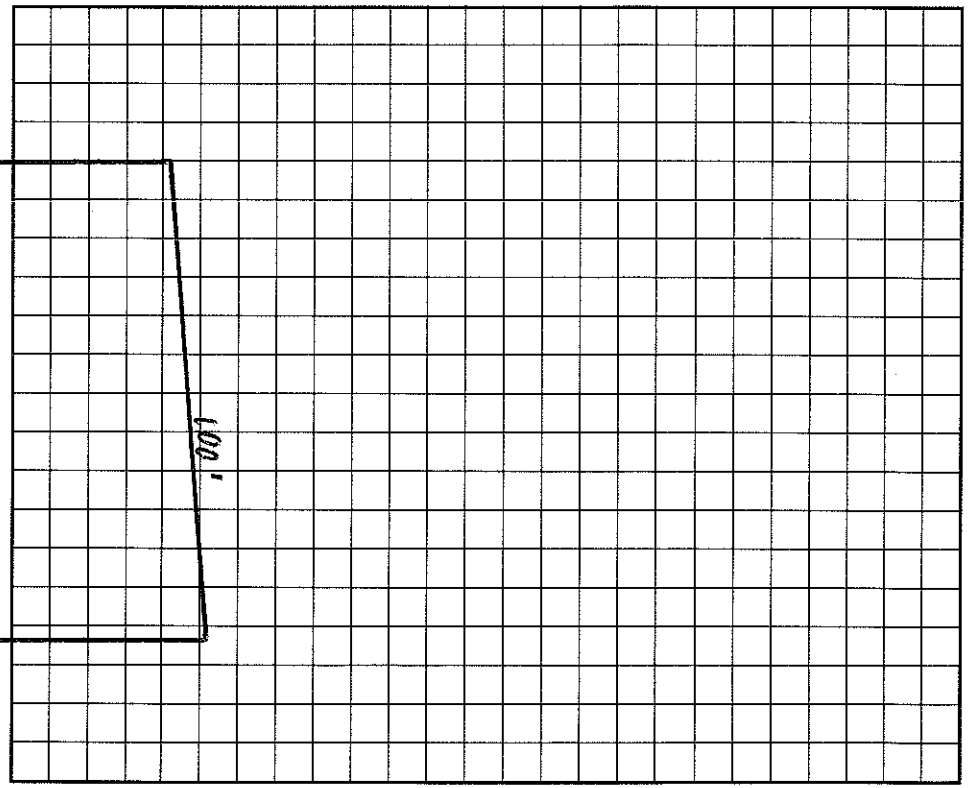

I understand that this permit can be suspended or revoked if any false information is supplied toward securing the permit/any unauthorized changes are made to the site/any unauthorized changes are made in the installation of the system. Improvement Permit is valid for 60 months from date of issuance.

Signed: Perry W Jenkins

Improvement Permit by: [signature] date 7/1/97

~~Existing System Inspection by:~~ AUTHORIZATION TO CONSTRUCT [signature] date 7/1/97

Installed by: Tommy Frye

Certificate of Completion by: Wesley Sparks RS. date 8/26/97

Operation Permit by: Wesley Sparks RS. date 8/26/97

HEALTH DEPT. COPY: WHITE INSPECTION COPY (FINAL): GREEN OWNER COPY (FINAL): YELLOW INSPECTION COPY (INITIAL): PINK OWNER COPY (INITIAL): GOLD