IREDELL COUNTY HEALTH DEPARTMENT

Authorization to Construct

STATESVILLE 704-878-5305 MOORESVILLE 704-664-5281

IMPROVEMENT PERMIT / ~~CERTIFICATE OF COMPLETION~~ / OPERATION PERMIT / EXISTING SYSTEM INSPECTION

PROPERTY DESCRIPTION NO. 23243 DATE 4/3/96 TAX MAP NO. Pt of 2P-D-8 Watershed: [X] Yes [ ] No

OWNER OR CONTRACTOR Piedmont Housing PHONE: Business 704-483-2469 Home

ADDRESS 301 E Main St. Lincolnton, NC. 28093 PIN# 4637-68-~~4382~~ 9292

LOCATION 150 W TL Kendra Dr. to 3RD lot on (R)

SUBDIVISION Doolie Meadow BLOCK / SECTION LOT ~~39~~ LOT AREA 23,455 SITE CLASS. PS DESIGN FLOW 360 L.T.A.R. .3

Septic Tank: 1000 Gallons; STB 824 Date 4/25/96
Pump Tank: Gallons; PT Date
Pump Make: Model Serial No.
Nitrification Field: No Fields 1 Square Feet 1260 Linear Feet 420
No Lines 6 Trench Width 36" Max Trench Bottom Depth 30" Gravel Depth 12"

[X] New System [ ] Repair System Type: I, II, III, IV, V, VI
System Description: Drop Box - Conventional
Repair System Description: Chamber - Plastic
Maintenance Agreement Required: [ ] Yes [X] No


[X] House/Mod. Home No. Bedrooms 3
[ ] Mobile Home No. Bathrooms 2
[ ] Business No. Employees
[ ] Other
[ ] Slab [X] Crawl Space [ ] Basement w/plumbing [ ] Basement wo/plumbing

Water Supply:
[ ] Individual
[X] Community
[ ] Public


Comments:

Comments:

INITIAL SITE SKETCH

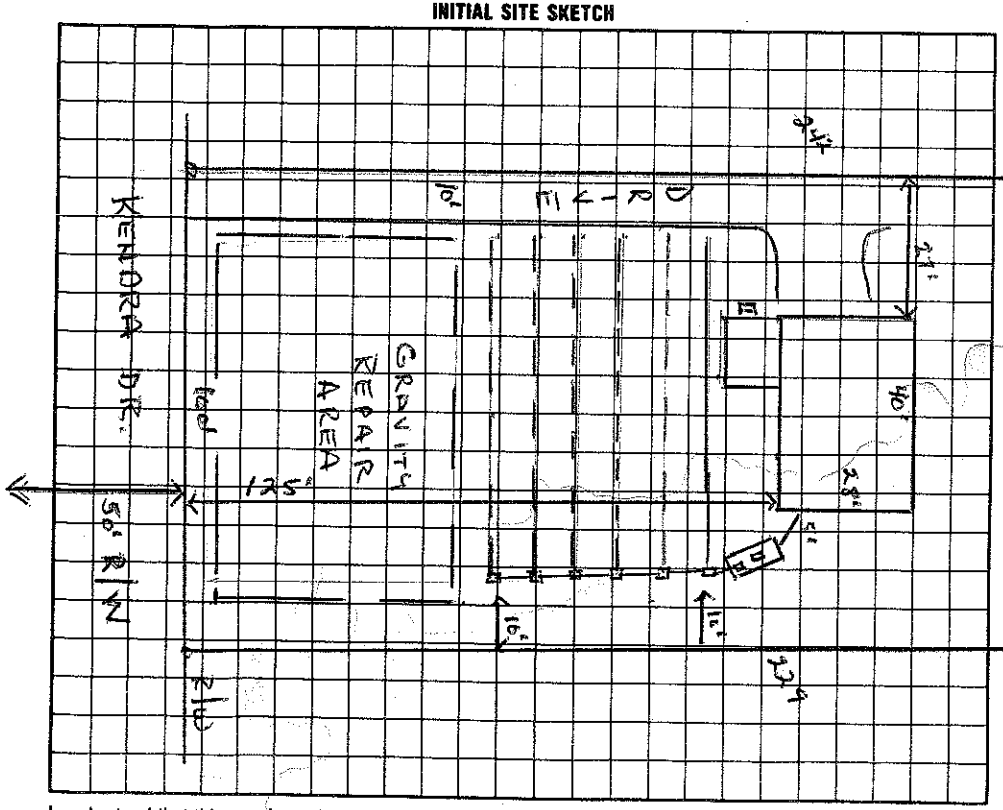

AS BUILT SKETCH

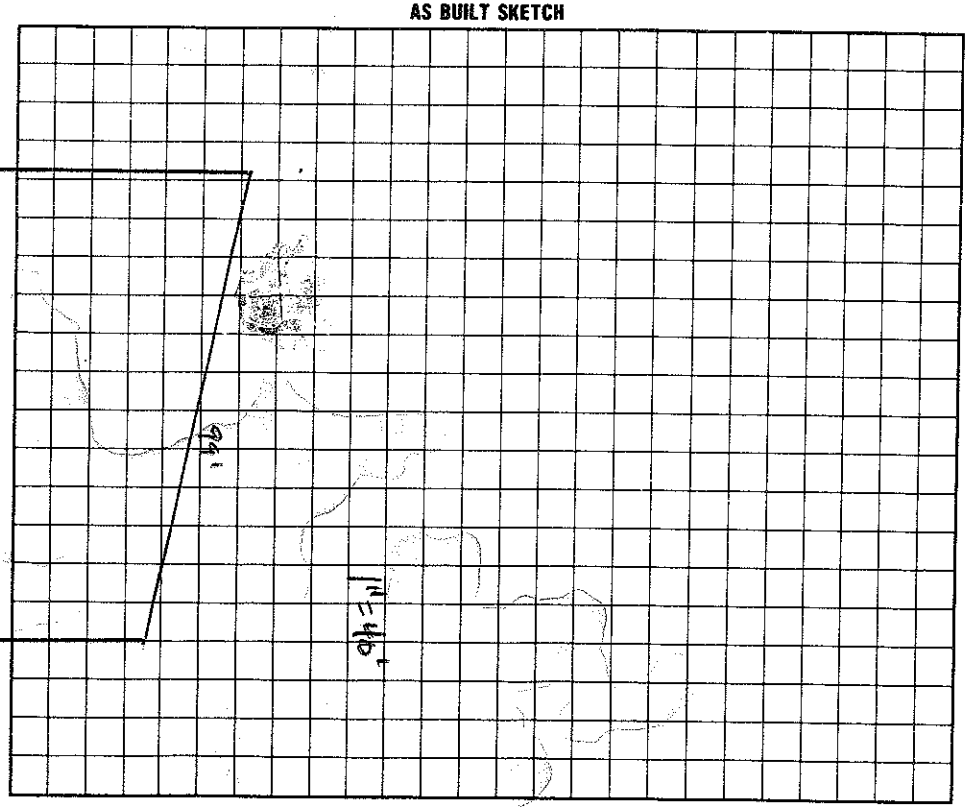

I understand that this permit can be suspended or revoked if any false information is supplied toward securing the permit/any unauthorized changes are made to the site/any unauthorized changes are made in the installation of the system.

Authorization to Construct valid 5 years.

Signed: Douglas W. [illegible]

Improvement Permit by: Wesley Sparks R.S. date 4/3/96

Authorization to Construct Existing System Inspection by: Wesley Sparks R.S. date 4/3/96

Installed by: G & M Enterprises

Certificate of Completion by: date

Operation Permit by: C. Bob Freeman BKS date 5/24/96

HEALTH DEPT. COPY: WHITE INSPECTION COPY (FINAL): GREEN OWNER COPY (FINAL): YELLOW INSPECTION COPY (INITIAL): PINK OWNER COPY (INITIAL): GOLD