IREDELL COUNTY HEALTH DEPARTMENT

AUTHORIZATION TO CONSTRUCT

PIN# 4637-68-9292

STATESVILLE 704-878-5305 MOORESVILLE 704-664-5281

IMPROVEMENT PERMIT / ~~CERTIFICATE OF COMPLETION~~ / OPERATION PERMIT / EXISTING SYSTEM INSPECTION

PROPERTY DESCRIPTION NO. 23243 DATE 11/4/96 TAX MAP NO. pt of 2P-D-8 Watershed: ☑ Yes ☐ No

OWNER OR CONTRACTOR PIEDMONT HOUSING PHONE: Business _____ Home _____

ADDRESS 301 E MAIN ST LINCOLNTON, NC 28093

LOCATION 150 W TL KENORA DR - 3rd LOT ON (R)

SUBDIVISION DOLLIE MEADOWS BLOCK / SECTION _____ LOT 3 LOT AREA 23455 SITE CLASS. PS DESIGN FLOW 360 L.T.A.R. .3

Septic Tank: 1600 Gallons; STB 321 Date 10/4/96

Pump Tank: _____ Gallons; PT _____ Date _____

Pump Make: _____ Model _____ Serial No. _____

Nitrification Field: No Fields 1 Square Feet 180' Linear Feet 60'

No Lines 1 Trench Width 36" Max Trench Bottom Depth 36" Gravel Depth 12"

☑ New System ☑ Repair System Type: I, II, III, IV, V, VI

System Description: GRAVITY DROP BOX CONV.

Repair System Description: _____

Maintenance Agreement Required: ☐ Yes ☑ No

☑ House/Mod. Home No. Bedrooms 3

☐ Mobile Home No. Bathrooms 2

☐ Business No. Employees _____

☐ Other _____


☐ Slab ☑ Crawl Space ☐ Basement w/plumbing ☐ Basement wo/plumbing

Water Supply: ☐ Individual ☑ Community ☐ Public


Comments: ONE NEW LINE SHALL BE ADDED AT 60'. SEVEN DROP BOXES SHALL BE ADDED FOR A TOTAL OF 420'. TEN FEET OF EXISTING SIX LINES SHALL BE CUT OFF UNDER DRIVE.

Comments:

INITIAL SITE SKETCH (1" = 40')

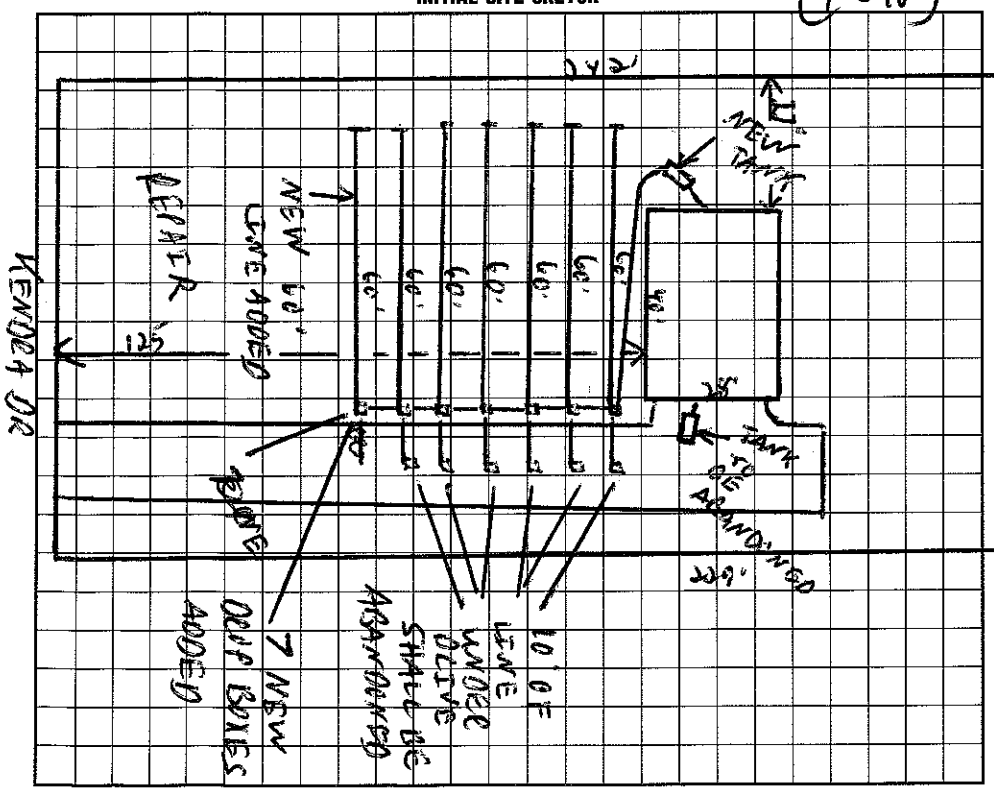

AS BUILT SKETCH

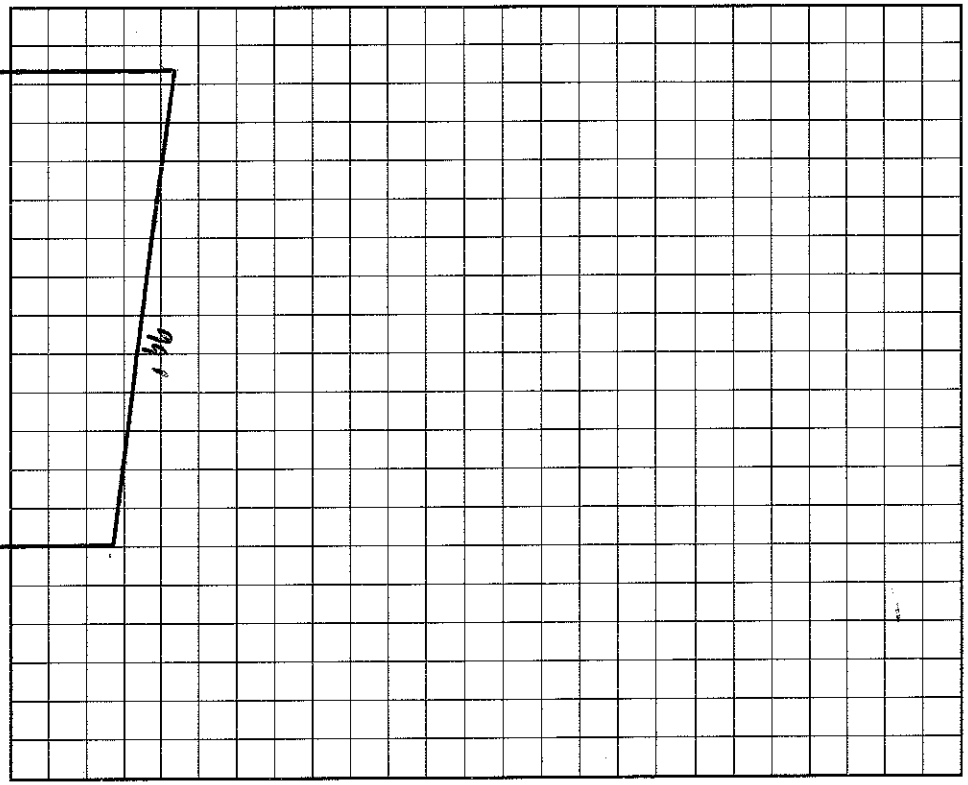

I understand that this permit can be suspended or revoked if any false information is supplied toward securing the permit/any unauthorized changes are made to the site/any unauthorized changes are made in the installation of the system.

Signed: _____ Installed by: Gary Miller

Improvement Permit by: C. Ben Ray Keen EHSI date 11/4/96

AUTHORIZATION TO CONSTRUCT

~~Existing System Inspection by~~: C. Ben Ray Keen EHSI date 11/4/96

Certificate of Completion by: _____ date _____

Operation Permit by: Wesley Sparks RS. date 11/13/96

HEALTH DEPT. COPY: WHITE INSPECTION COPY (FINAL): GREEN OWNER COPY (FINAL): YELLOW INSPECTION COPY (INITIAL): PINK OWNER COPY (INITIAL): GOLD