IREDELL COUNTY HEALTH DEPARTMENT

Authorization to Construct PIN# 4637-68-9382

STATESVILLE 704-878-5305 MOORESVILLE 704-664-5281

IMPROVEMENT PERMIT / CERTIFICATE OF COMPLETION / OPERATION PERMIT / EXISTING SYSTEM INSPECTION

PROPERTY DESCRIPTION NO. 23242 DATE 4/3/96 TAX MAP NO. 2P D 8 Watershed: ☒ Yes ☐ No

OWNER OR CONTRACTOR Piedmont Housing PHONE: Business 704-483-2469 Home

ADDRESS 301 E Main St. Lincolnton, NC. 28093

LOCATION 150 IN TL on Kendra Dr. to 2nd lot on (R)

SUBDIVISION Doolie Meadows BLOCK / SECTION LOT 2 LOT AREA 22,400 SITE CLASS. PS DESIGN FLOW 360 L.T.A.R. .3

Septic Tank: 1000 Gallons; STB 821 Date 4/25/96

Pump Tank: Gallons; PT Date

Pump Make: Model Serial No.

Nitrification Field: No Fields 1 Square Feet 1260 Linear Feet (420)

No Lines 6 Trench Width 36" Max Trench Bottom Depth 32" Gravel Depth

☒ New System ☐ Repair System Type: I II III IV V VI

System Description: Drop Box Conventional

Repair System Description: Chamber / Plastic

Maintenance Agreement Required: ☐ Yes ☐ No

☒ House/Mod. Home No. Bedrooms 3

☐ Mobile Home No. Bathrooms 2

☐ Business No. Employees

☐ Other


☐ Slab ☒ Crawl Space ☐ Basement w/plumbing ☐ Basement wo/plumbing

Water Supply: ☒ Individual ☒ Community ☐ Public


Comments: ~~420' of Chamber / Plastic - Type III~~
Sand backfill to top of louvers
420' Drop Box Conventional - Type II

Comments:
12" Washed Gravel

INITIAL SITE SKETCH

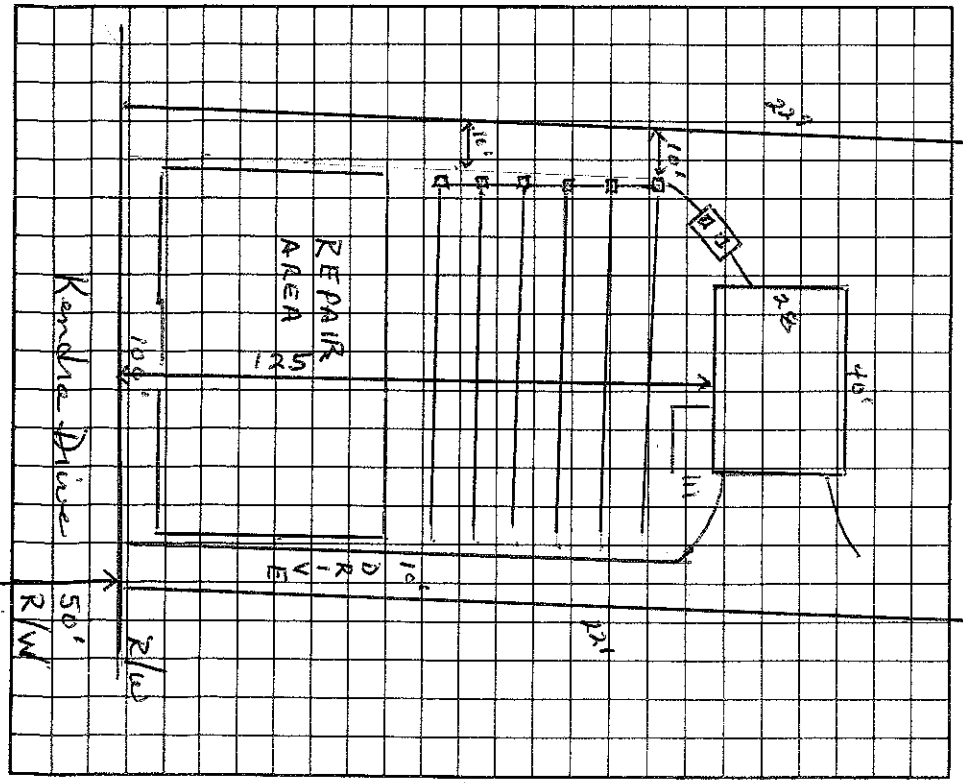

AS BUILT SKETCH

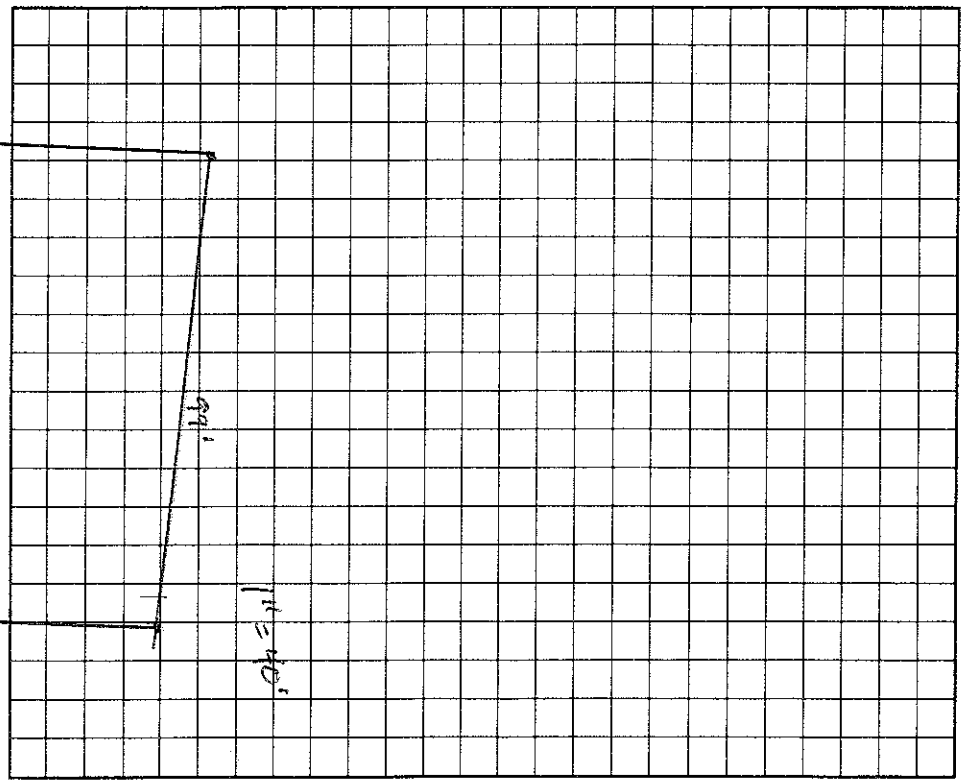

I understand that this permit can be suspended or revoked if any false information is supplied toward securing the permit/any unauthorized changes are made to the site/any unauthorized changes are made in the installation of the system.

Signed: X Authorization to Construct valid 5 years

Improvement Permit by: Wesley Sparks RS. date 4/3/96

Existing System Inspection by: Authorization to Construct Wesley Sparks RS date 4/3/96

Installed by: G & M Enterprises

Certificate of Completion by: date

Operation Permit by: EHSD date 5/24/96

HEALTH DEPT. COPY: WHITE INSPECTION COPY (FINAL): GREEN OWNER COPY (FINAL): YELLOW INSPECTION COPY (INITIAL): PINK OWNER COPY (INITIAL): GOLD