IREDELL COUNTY HEALTH DEPARTMENT

STATESVILLE 704-878-5305 MOORESVILLE 704-664-5281

IMPROVEMENT PERMIT / AUTHORIZATION TO CONSTRUCT / OPERATION PERMIT / EXISTING SYSTEM INSPECTION

PERMIT# 079133 PIN# 4637689992 DATE 3/17/99

OWNER OR CONTRACTOR FLOYD E. GREENE PHONE: Business Home 534-5179

ADDRESS PO BOX 1147 MOORESVILLE NC 28115

LOCATION 150 W - TL KENDRA - 2nd LOT ON R

SUBDIVISION POOLE MEADOWS BLOCK / SECTION LOT 1 LOT AREA .16 AC SITE CLASS. RS DESIGN FLOW ~~120~~ 180 GPD L.T.A.R. .13

Septic Tank: 1000 Gallons; STB 794 Date 3/6/00
Pump Tank: Gallons; PT Date
Pump Make: Model Serial No.
Nitrification Field: No Fields 1 Square Feet 210 Linear Feet 630
No Lines 3 @ 70' Trench Width 36" Max Trench Bottom Depth 36" Gravel Depth 12"

☑ New System ☐ Repair System Type: I II III IV V VI
System Description: GRAVITY CONVENTIONAL
Repair System Description: ~~SEPTIC~~ PUMP CONVERTED TO GRAVITY
Maintenance Agreement Required: ☐ Yes ☑ No

☑ House/Mod. Home No. Bedrooms
☐ Mobile Home No. Bathrooms
☐ Business No. Employees
☐ Other 7 EMPLOYEES


☐ Slab ☑ Crawl Space ☐ Basement w/plumbing ☐ Basement wo/plumbing

Water Supply:
☐ Individual
☐ Public
☑ Community


Comments:/Conditions: OPERATION PERMIT WILL NOT BE ISSUED UNTIL WELL IS ABANDONED PROPERLY.

Comments:/Conditions: Well abandoned

INITIAL SITE SKETCH

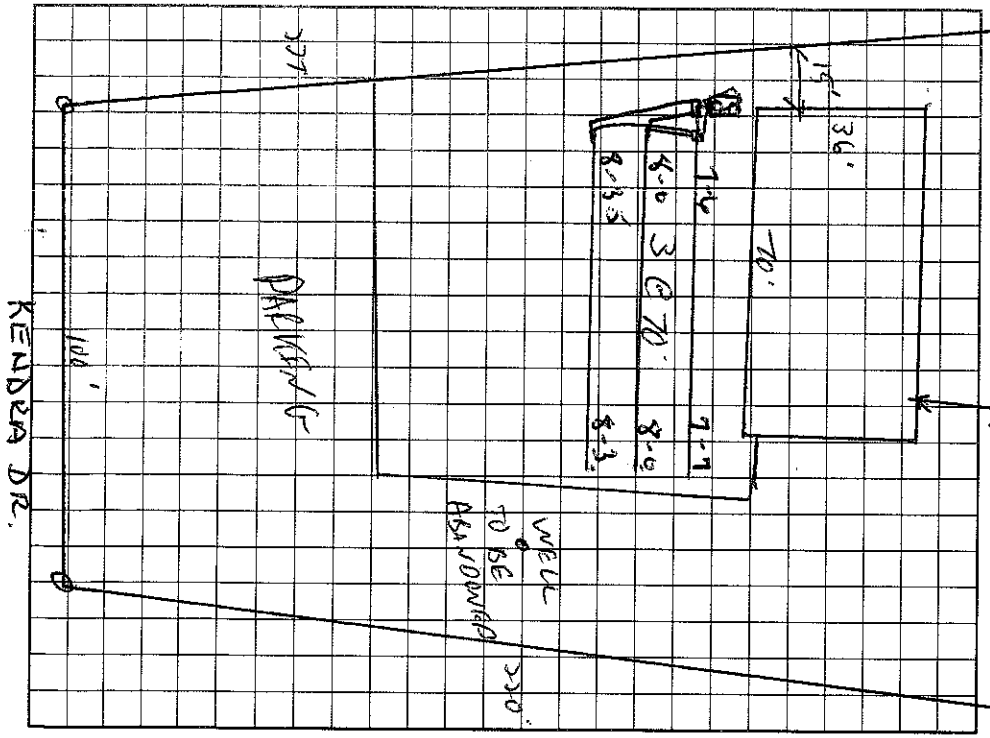

AS BUILT SKETCH

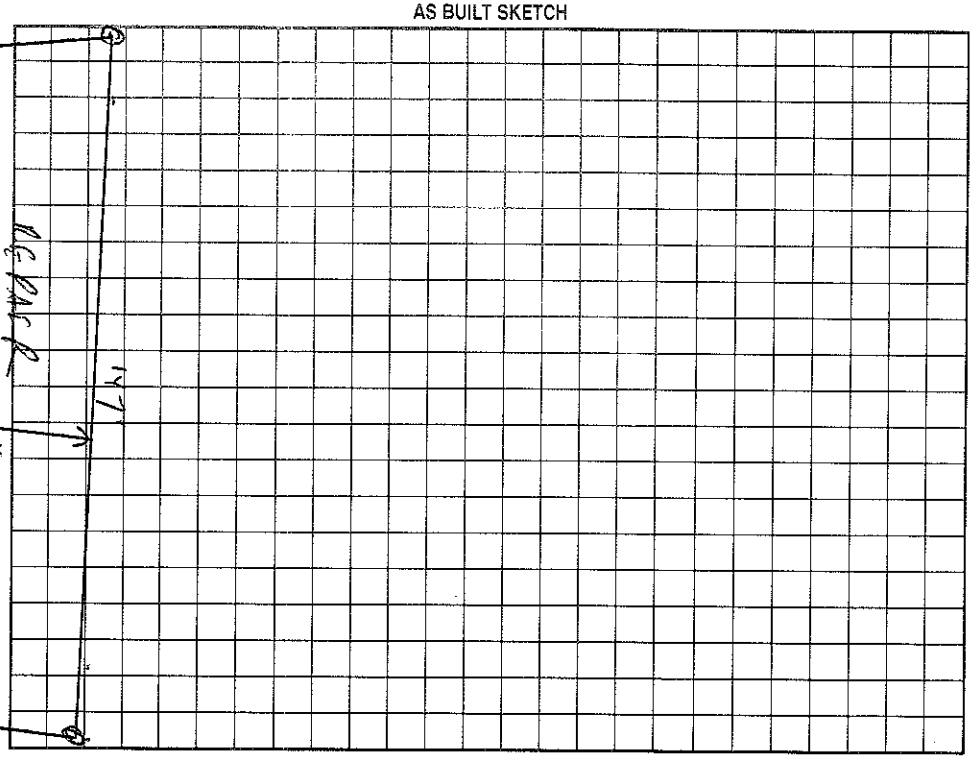

Permit can be suspended or revoked if any false information is supplied toward securing the permit/any unauthorized changes are made to the site/any unauthorized changes are made in the installation of the system. Improvement Permit with plat valid without expiration. Improvement Permit with site plan valid for sixty months. Authorization to Construct is valid for a period equal to that of Improvement Permit – not to exceed sixty months.

Signed: date 3-19-99 Installed by: F J Erwin

Improvement Permit by: RS date 3/17/99 Operation Permit by: Wesley Sparks RS date 4/24/00

Authorization to Construct by: RS date 3/17/99 Existing System Inspection by: date

HEALTH DEPT. COPY: WHITE OWNER COPY (FINAL): YELLOW OWNER COPY (INITIAL): PINK