1:00

IREDELL COUNTY HEALTH DEPARTMENT

STATESVILLE 704-878-5305 MOORESVILLE 704-664-5281

IMPROVEMENT PERMIT / AUTHORIZATION TO CONSTRUCT / OPERATION PERMIT / EXISTING SYSTEM INSPECTION

PERMIT# 151323 PIN# 4637701540 DATE 7/8/08

OWNER OR APPLICANT Mike Reece / Helen Reece PHONE: Business 704-560-9447 Home 336-414-6052

ADDRESS 514 Oak Tree Rd.

LOCATION Bowles School Rd., TR Oak Tree, on Left, 179 Oak Tree

SUBDIVISION — BLOCK / SECTION — LOT — LOT AREA 1.86 acres SITE CLASS. P.S. DESIGN FLOW 720 gpd T.A.R. 0.3

Septic Tank: 1500 Gallons: STB 330 Date 6/28/08
Pump Tank: ____ Gallons: PT ____ Date ____
Pump Make: ____ Model ____ Serial No. ____
Nitrification Field: No Fields 1 Square Feet 2400 Linear Feet 600
No Lines 10 Trench Width 36" Max Trench Bottom Depth 36"

☑ New System ☐ Repair ☐ Expansion System Type: I II III IV V VI
System Description: 25% Reduction, gravity
Repair System Description: 50% pump
Maintenance Agreement Required: ☐ Yes ☑ No


☑ House/Mod. Home No. Bedrooms 6
☐ Mobile Home No. Persons ____
☐ Business No. Employees ____
☑ Other Accessory Buildings

Water Supply: ☑ Individual ☐ Public ☐ Community

Gravel Depth — ☑ Gravity ☐ Pressure ☐ Slab ☑ Crawl Space ☐ Basement w/plumbing ☐ Basement wo/plumbing

Comments/Conditions: - maintain all setbacks, install on contour
- may use end cap dist. w/ infiltrator
- No AC until Floor Plan for Garage is reviewed
- Garage is considered 2 bedrooms

INITIAL SITE SKETCH not to scale

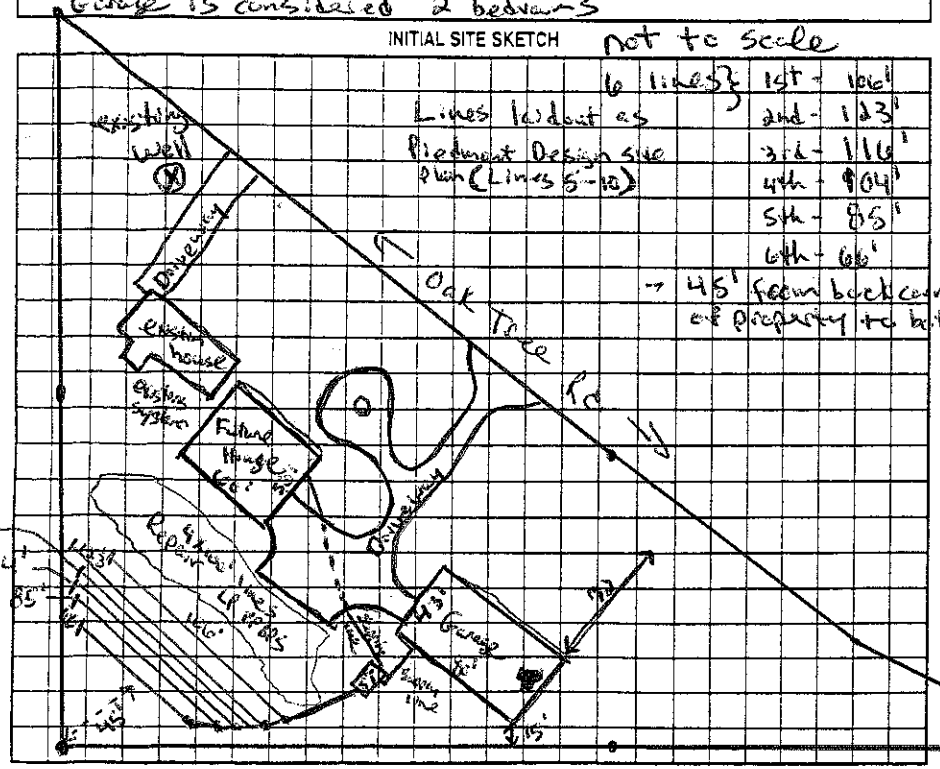

Comments/Conditions: - Existing system check required before building future house, review house plan (V for few bedrooms)
- Sleeve supply line under driveway and from house to tank, and have a cleanout every 75'

AS BUILT SKETCH

#1 Abandon existing system when Future House is built.

Red Flag

Permit can be suspended or revoked if any false information is supplied toward securing the permit/any unauthorized changes are made to the site/any unauthorized changes are made in the installation of the system. Improvement Permit with plat valid without expiration ☐ Improvement Permit with site plan valid for sixty months ☑ Authorization to Construct is valid for a period equal to that of Improvement Permit – not to exceed sixty months.

Signed: Mike Reece date 7-9-08 Installed by: Richard Abernathy

Improvement Permit by: Randy Moore date 7/8/08 Operation Permit by: Randy Moore date 10/31/08

Authorization to Construct by: Randy Moore date 10/7/08 Existing System Inspection by: ____ date ____

HEALTH DEPT. COPY: WHITE OWNER COPY (FINAL): YELLOW OWNER COPY (INITIAL): PINK