MEDELL COUNTY HEALTH DEPARTMENT

Authorization to ...

STATESVILLE 704-878-5305 MOORESVILLE 704-664-5281

IMPROVEMENT PERMIT / ~~CERTIFICATE OF COMPLETION~~ / OPERATION PERMIT / EXISTING SYSTEM INSPECTION

PROPERTY DESCRIPTION NO. Repair DATE 5/1/96 TAX MAP NO. 4637701807

OWNER OR CONTRACTOR Patt Meletis PHONE: Business 664-6556 Home 664-7766 Watershed: ☐ Yes ☒ No

ADDRESS 186 Oak Tree Rd. Mooresville, NC. 28115

LOCATION on (R) of Oak Tree Rd just before Harborcrest Subdivision

SUBDIVISION N/A BLOCK / SECTION ____ LOT ____ LOT AREA ____ SITE CLASS. ____ DESIGN FLOW 600 L.T.A.R. 375

Septic Tank: 1500 Gallons; STB ____ Date ____

Pump Tank: ____ Gallons; PT ____ Date ____

Pump Make: ____ Model ____ Serial No. ____

Nitrification Field: No Fields 1 Square Feet 1800 Linear Feet 500

No Lines 5 Trench Width 36" Max Trench Bottom Depth AS REQUIRED Gravel Depth 12"

☐ New System ☒ Repair System Type: I (II) III. IV. V. VI

System Description: Conventional System

Repair System Description: ____

Maintenance Agreement Required: ☐ Yes ☐ No

☐ Slab ☐ Crawl Space ☒ Basement w/plumbing ☐ Basement wo/plumbing

☒ House/Mod. Home No. Bedrooms 5

☐ Mobile Home No. Bathrooms ____

☐ Business No. Employees ____

☐ Other ____


Water Supply: ☒ Individual ☐ Community ☐ Public

Comments: Set new Dist Box as shown here - Trenches deep as necessary - much improved soil conditions

Comments: MH under Stability - Completion


6' Deep lines

INITIAL SITE SKETCH

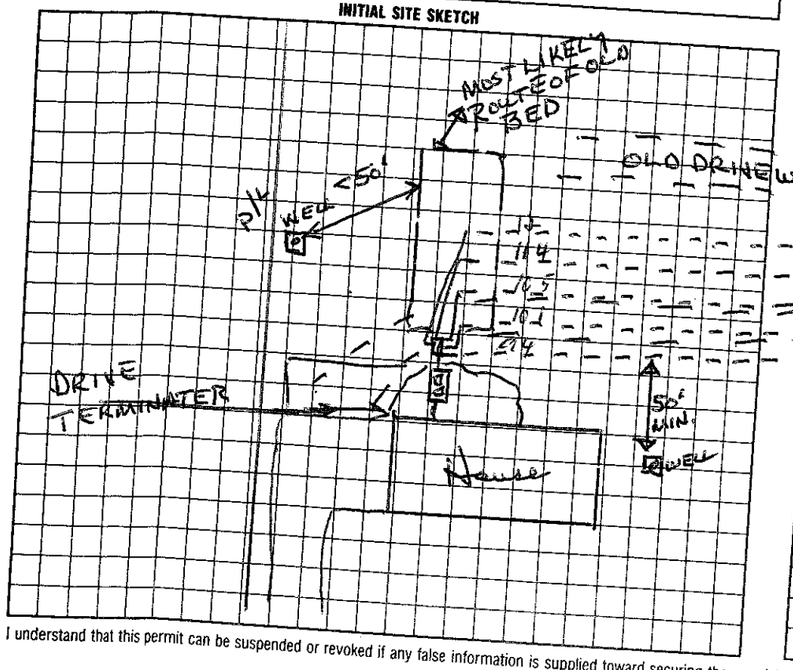

AS BUILT SKETCH

(8' from tank to D-Box)
(Tank 32' from house)
(4' Deep)

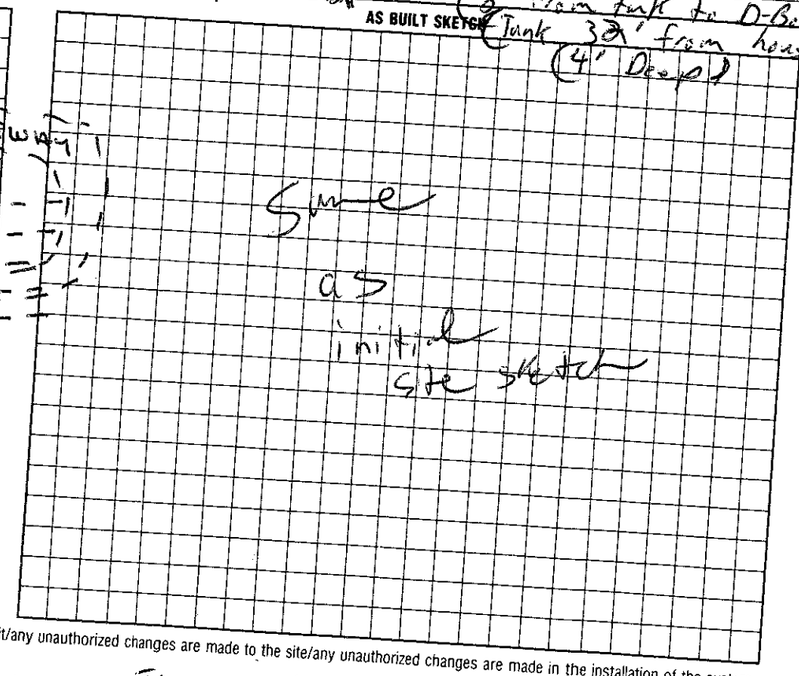

I understand that this permit can be suspended or revoked if any false information is supplied toward securing the permit/any unauthorized changes are made to the site/any unauthorized changes are made in the installation of the system.

Signed: ____

Improvement Permit by: ____ date ____

Existing System Inspection by: Hereto Construct Wesley Sparks RS. date 5/1/96

Installed by: Thompson's Earthworks

Certificate of Completion by: ____ date ____

Operation Permit by: C. Bradley Thompson EHSE date 5/14/96

HEALTH DEPT. COPY: WHITE — INSPECTION COPY (FINAL): GREEN — OWNER COPY (FINAL): YELLOW — INSPECTION COPY (INITIAL): PINK — OWNER COPY (INITIAL): GOLD