IREDELL COUNTY HEALTH DEPARTMENT

Authorization to Construct

STATESVILLE 704-878-5305 MOORESVILLE 704-664-5281

IMPROVEMENT PERMIT / ~~CERTIFICATE OF COMPLETION~~ / OPERATION PERMIT / EXISTING SYSTEM INSPECTION

PROPERTY DESCRIPTION NO. Repair DATE 5/1/96 TAX MAP NO. 4637701807 Watershed: ☐ Yes ☒ No

OWNER OR CONTRACTOR Pete Meletis PHONE: Business 664-6556 Home 664-7766

ADDRESS 186 Oak Tree Rd. Mooresville, NC. 28115

LOCATION on (R) of Oak Tree Rd just before Harborcrest Subdivision

SUBDIVISION N/A BLOCK / SECTION ____ LOT ____ LOT AREA ____ SITE CLASS. ____ DESIGN FLOW 1000 L.T.A.R. .35

Septic Tank: 1500 Gallons; STB ____ Date ____

Pump Tank: ____ Gallons; PT ____ Date ____

Pump Make: ____ Model ____ Serial No. ____

Nitrification Field: No. Fields 1 Square Feet 1800 Linear Feet 500

No. Lines 5 Trench Width 36" Max Trench Bottom Depth AS REQUIRED Gravel Depth 12"

☐ New System ☒ Repair System Type: I (II) III, IV, V, VI

System Description: Conventional System

Repair System Description: ____

Maintenance Agreement Required: ☐ Yes ☐ No

☒ House/Mod. Home No. Bedrooms 5

☐ Mobile Home No. Bathrooms ____

☐ Business No. Employees ____

☐ Other ____

☐ Slab ☐ Crawl Space ☒ Basement w/plumbing ☐ Basement wo/plumbing


Water Supply: ☒ Individual ☐ Community ☐ Public

Comments: Set new Dist Box as shown here - Trenches deep as necessary - much improved soil conditions

Comments: MH under Safety - Completion

6' Deep lines (8' from tank to D-Box) (Tank 30' from house) (4" Deep)

INITIAL SITE SKETCH

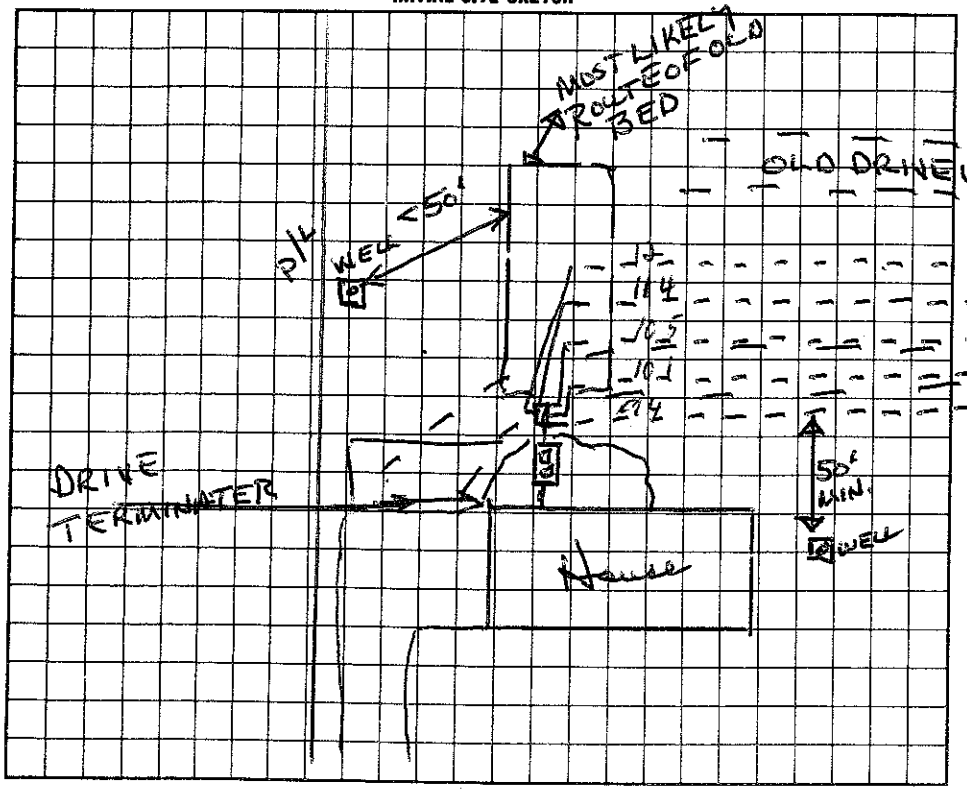

AS BUILT SKETCH

Same as initial site sketch

I understand that this permit can be suspended or revoked if any false information is supplied toward securing the permit/any unauthorized changes are made to the site/any unauthorized changes are made in the installation of the system.

Signed: ____

Installed by: Thompson's Earthworks

Improvement Permit by: ____ date ____

Certificate of Completion by: ____ date ____

Existing System Inspection by: Authorization to Construct Wesley Sparks RS. date 5/1/96

Operation Permit by: C. Bush Thomas EHSI date 5/14/96

HEALTH DEPT. COPY: WHITE INSTALLATION COPY (FINAL): GREEN OWNER COPY (FINAL): YELLOW INSPECTION COPY (INITIAL): PINK OWNER COPY (INITIAL): GOLD