4637-71-1166

IREDELL COUNTY HEALTH DEPARTMENT Const. Auth

STATESVILLE 704-878-5305 MOORESVILLE 704-664-5281

IMPROVEMENT PERMIT / ~~CERTIFICATE OF COMPLETION~~ / OPERATION PERMIT / EXISTING SYSTEM INSPECTION

PROPERTY DESCRIPTION NO. 21023 DATE Feb 12, 97 TAX MAP NO. part of 2RA41A Watershed: ☑ Yes ☐ No

OWNER OR CONTRACTOR ~~Ford Complex~~ Ray Short PHONE: Business _____ Home _____

ADDRESS 2247 Charlotte Hwy. Mooresville

LOCATION Brawley School Rd. & TR Oak Tree Rd. TR Harborcrest on Right

SUBDIVISION Harborcrest BLOCK / SECTION _____ LOT 19 LOT AREA 100' X ~295' SITE CLASS. PS DESIGN FLOW 360gpd L.T.A.R. .3

Septic Tank: 1000 Gallons; STB 794 Date 9/18/96

Pump Tank: _____ Gallons; PT _____ Date _____

Pump Make: _____ Model _____ Serial No. _____

Nitrification Field: No Fields 1 Square Feet 1200 Linear Feet 400

No Lines 4 Trench Width 36" Max Trench Bottom Depth 36" Gravel Depth 12"

☑ New System ☐ Repair System Type: I, (II), III, IV, V, VI

System Description: gravity conventional

Repair System Description: gravity/pumped chambered

Maintenance Agreement Required: ☐ Yes ☑ No

☑ House/Mod. Home No. Bedrooms 3

☐ Mobile Home No. Bathrooms 2

☐ Business No. Employees ____

☐ Other _____

☐ Slab ☑ Crawl Space ☐ Basement w/plumbing ☐ Basement wo/plumbing


Water Supply: ☑ Individual ☐ Community ☐ Public

Comments: S 0 30


Comments:

1"=50'

INITIAL SITE SKETCH

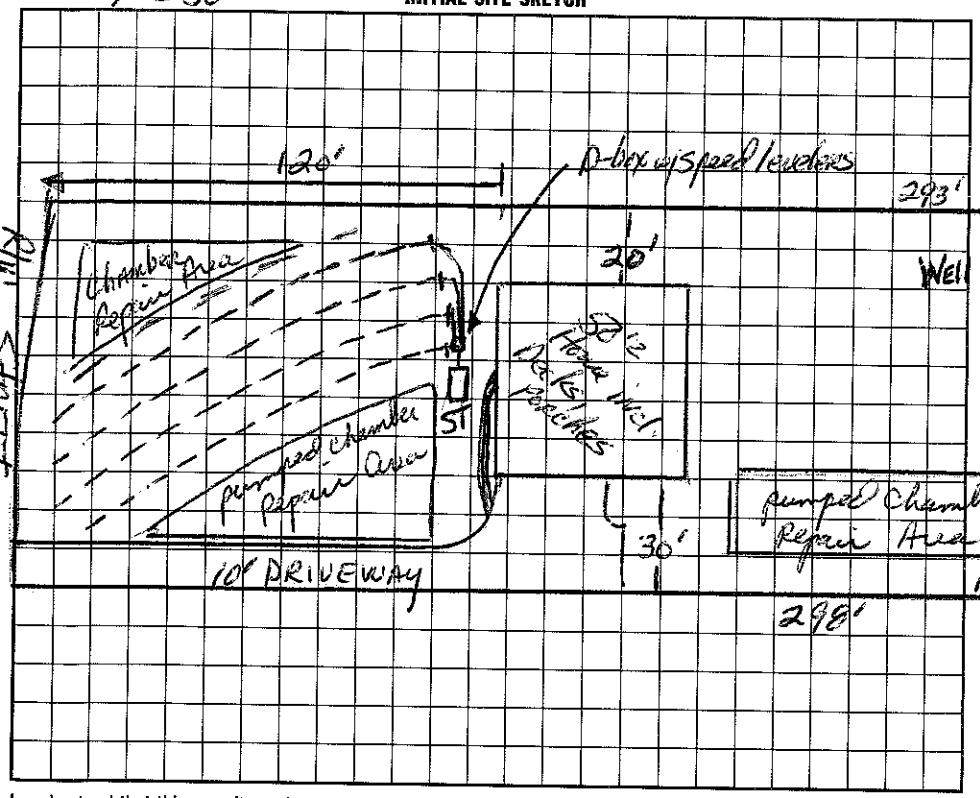

AS BUILT SKETCH

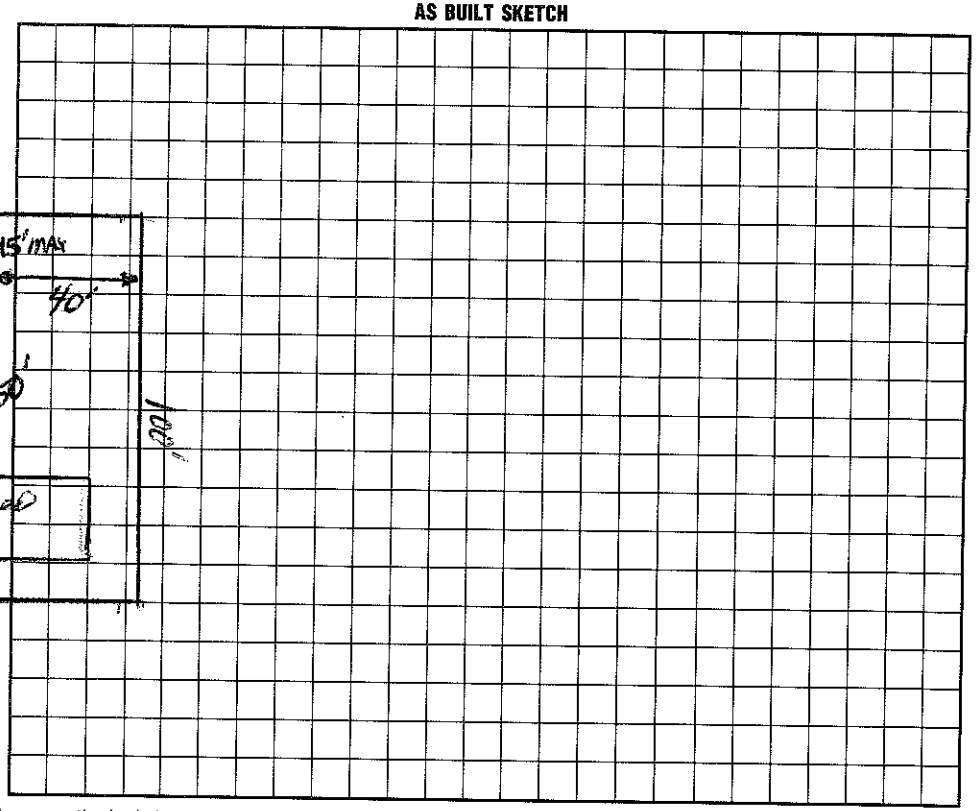

I understand that this permit can be suspended or revoked if any false information is supplied toward securing the permit/any unauthorized changes are made to the site/any unauthorized changes are made in the installation of the system. Improvement Permit is valid for 60 months from date of issuance.

Signed: _____

Improvement Permit by: David R. Thurm RS date 2-12-97

~~Existing System Inspection by:~~ D R Thurm RS date 7-27-98

Installed by: FD Ervin

Certificate of Completion by: _____ date _____

Operation Permit by: _____ date 11/13/98

HEALTH DEPT. COPY: WHITE INSPECTION COPY (FINAL): GREEN OWNER COPY (FINAL): YELLOW INSPECTION COPY (INITIAL): PINK OWNER COPY (INITIAL): GOLD