4637-71-1376 3130

IREDELL COUNTY HEALTH DEPARTMENT Const. Auth. STATESVILLE 704-878-5305 MOORESVILLE 704-664-5281

IMPROVEMENT PERMIT / ~~CERTIFICATE OF COMPLETION~~ / OPERATION PERMIT / EXISTING SYSTEM INSPECTION

PROPERTY DESCRIPTION NO. 24021 DATE Feb-10, '97 TAX MAP NO. part of 2KA41A Watershed: ☑ Yes ☐ No

OWNER OR CONTRACTOR Paul Crumb / Ray Short PHONE: Business _____ Home _____

ADDRESS 2247 Charlotte Hwy Mooresville

LOCATION Brawley Sch Rd TR OAK Tree TR Harborcrest, on Right

SUBDIVISION Harborcrest BLOCK / SECTION _____ LOT 17 LOT AREA 100 X ~276' SITE CLASS. PS pre-1956 DESIGN FLOW 360 gpd L.T.A.R. .83

Septic Tank: 1000 Gallons; STB _____ Date _____

Pump Tank: _____ Gallons; PT _____ Date _____

Pump Make: _____ Model _____ Serial No. _____

Nitrification Field: No Fields 1 Square Feet 1200 Linear Feet 400

No Lines 4 Trench Width 36" Max Trench Bottom Depth 24" Gravel Depth 12"

☑ New System ☐ Repair System Type: I, II, III, IV, V, VI

System Description: gravity conventional

Repair System Description: Grav/pumped

Maintenance Agreement Required: ☐ Yes ☑ No

☑ House/Mod. Home No. Bedrooms 3

☐ Mobile Home No. Bathrooms 2

☐ Business No. Employees _____

☐ Other _____


☐ Slab ☑ Crawl Space ☐ Basement w/plumbing ☐ Basement wo/plumbing

Water Supply: ☑ Individual ☐ Community ☐ Public


Comments:

Comments:

INITIAL SITE SKETCH 1"=50'

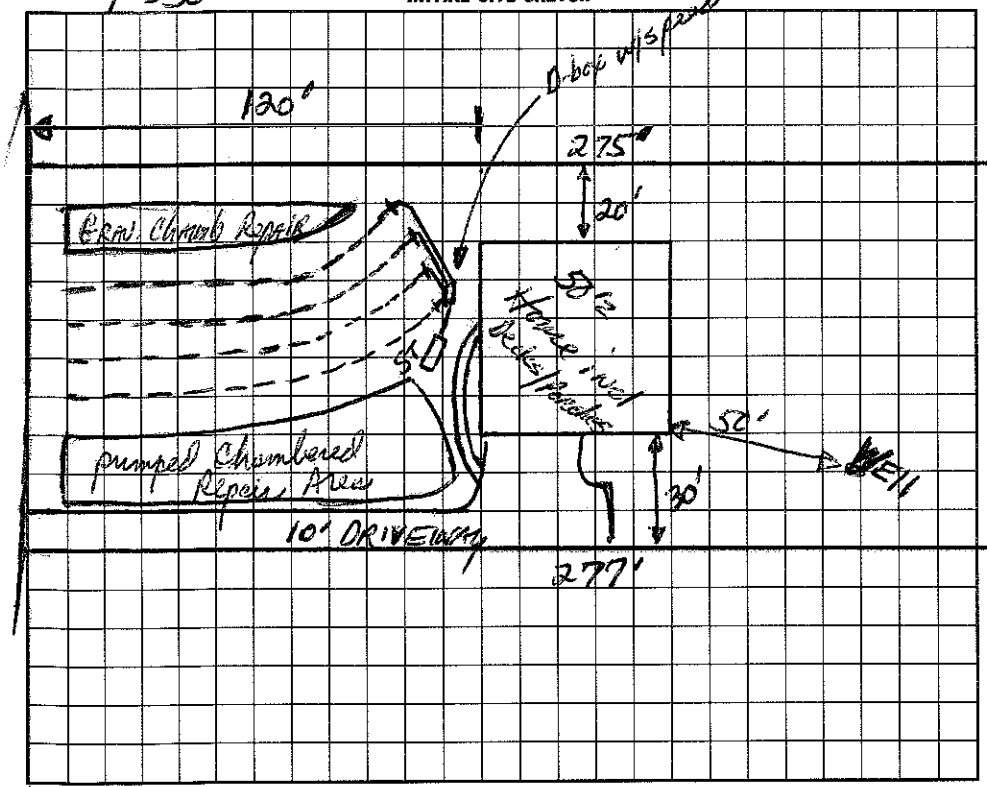

AS BUILT SKETCH

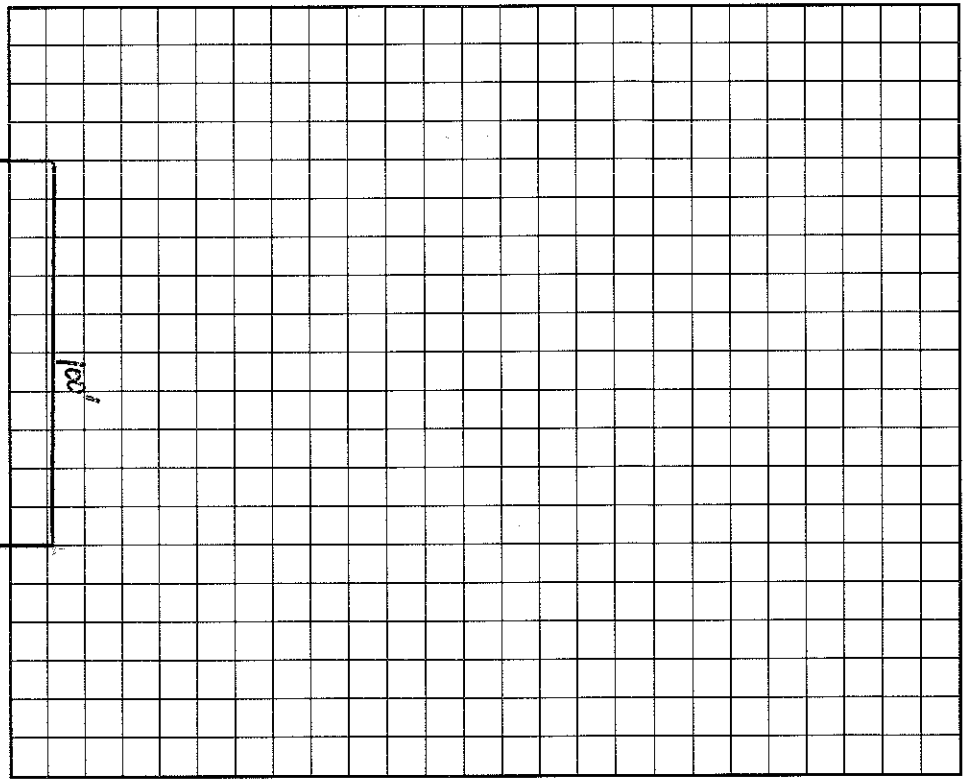

I understand that this permit can be suspended or revoked if any false information is supplied toward securing the permit/any unauthorized changes are made to the site/any unauthorized changes are made in the installation of the system. Improvement Permit is valid for 60 months from date of issuance.

Signed: Paul Crumb

Improvement Permit by: Wayne R Hinson, RS date 2-10-97

~~Existing System Inspection by:~~ Construction Authorization Wayne R Hinson, RS date 2-10-97

Installed by: FS Ervin

Certificate of Completion by: [signature] date 6/4/98

Operation Permit by: _____ date _____

HEALTH DEPT. COPY: WHITE INSPECTION COPY (FINAL): GREEN 3-5-98 OWNER COPY (FINAL): YELLOW INSPECTION COPY (INITIAL): PINK OWNER COPY (INITIAL): GOLD