4637-71-1576

IREDELL COUNTY HEALTH DEPARTMENT

STATESVILLE 704-878-5305 MOORESVILLE 704-664-5281

IMPROVEMENT PERMIT / CERTIFICATE OF COMPLETION / OPERATION PERMIT / EXISTING SYSTEM INSPECTION

PROPERTY DESCRIPTION NO. 21019 DATE June 3, '96 TAX MAP NO. part of 2KA44A Watershed: ☐ Yes ☐ No

OWNER OR CONTRACTOR Larry Davis PHONE: Business _____ Home _____

ADDRESS 450 Oak Tree Rd, Mrsvl.

LOCATION Bramley School Road TR Oak Tree Rd. TR Harborcrest Ln. on Right

SUBDIVISION Harborcrest BLOCK / SECTION _____ LOT 15 LOT AREA 25,000sqft+ SITE CLASS. PS part 1&2 DESIGN FLOW 360gpd L.T.A.R. .3

Septic Tank: 1000 Gallons; STB _____ Date _____

Pump Tank: _____ Gallons; PT _____ Date _____

Pump Make: _____ Model _____ Serial No. _____

Nitrification Field: No Fields 1 Square Feet 900 Linear Feet 300

No Lines 3@100' Trench Width 36" Max Trench Bottom Depth 36" Gravel Depth NA

☑ New System ☐ Repair System Type: I, II, III, IV, V, VI

System Description: gravity chambered

Repair System Description: gravel pumped chambered

Maintenance Agreement Required: ☐ Yes ☑ No

☑ House/Mod. Home No. Bedrooms 3

☐ Mobile Home No. Bathrooms 2.5

☐ Business No. Employees _____

☐ Other _____

☐ Slab ☐ Crawl Space ☑ Basement w/plumbing ☐ Basement wo/plumbing


Water Supply: ☑ Individual ☐ Community ☐ Public

Comments: Redraw & permit issued 11-13-95 due to Basement - Plumbery must exit on top of footing As discussed on site w/ tank kept shallow and minimum fall used to D-box / OR A pump will be Required


Comments: PARTIAL

1"=50'

INITIAL SITE SKETCH

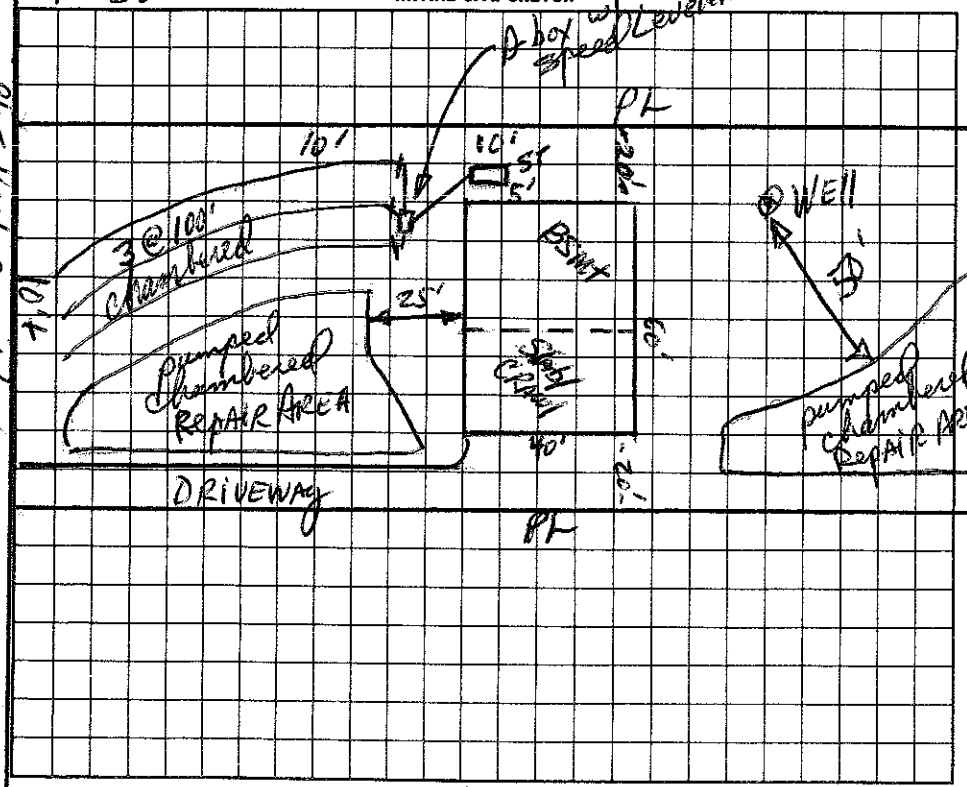

AS BUILT SKETCH

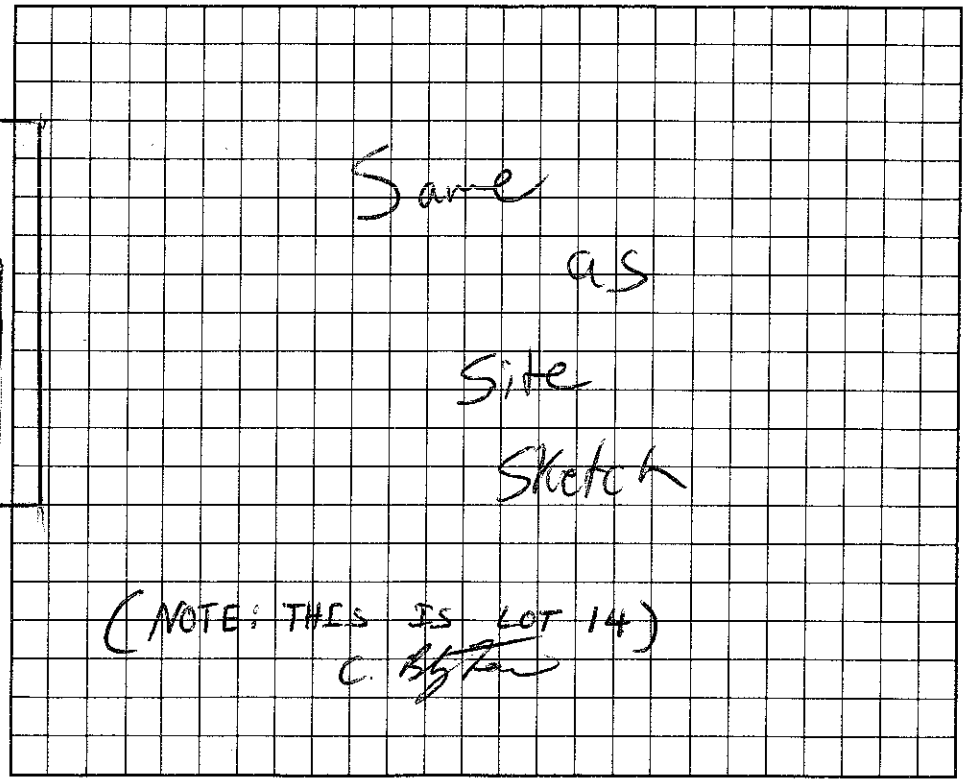

I understand that this permit can be suspended or revoked if any false information is supplied toward securing the permit/any unauthorized changes are made to the site/any unauthorized changes are made in the installation of the system.

Signed: _____

Improvement Permit by: _____ date 6-3-96

Existing System Inspection by: _____ date 6-3-96

Installed by: BARRY THOMPSON

Certificate of Completion by: _____ date _____

Operation Permit by: C. Bryan EHSI date 1/9/96

CONSTRUCTION AUTHORIZATION

HEALTH DEPT. COPY: WHITE INSPECTION COPY (FINAL): GREEN OWNER COPY (FINAL): YELLOW INSPECTION COPY (INITIAL): PINK OWNER COPY (INITIAL): GOLD