4637-71-1676

IREDELL COUNTY HEALTH DEPARTMENT

Const. Auth. STATESVILLE 704-878-5305 MOORESVILLE 704-664-5281

IMPROVEMENT PERMIT / ~~CERTIFICATE OF COMPLETION~~ / ~~OPERATION PERMIT / EXISTING SYSTEM INSPEC~~

PROPERTY DESCRIPTION NO. 21018 DATE March 21, 1996 TAX MAP NO. part of 2KA41A Watershed: ☑ Yes ☐

OWNER OR CONTRACTOR MT Investments / Larry Davis PHONE: Business Home 664-9407

ADDRESS 450 Oak Tree Rd, Mooresville

LOCATION Brawley Sch Rd. TR Oak Tree Rd TR Harborcrest on Right near end

SUBDIVISION HARBORCREST BLOCK / SECTION LOT 14 LOT AREA 100'x 275' SITE CLASS Spec 1950 DESIGN FLOW 360 gpd L.T.A.R. .3

Septic Tank: 1000 Gallons; STB 825 Date 2/17/96
Pump Tank: Gallons; PT Date
Pump Make: Model Serial No.
Nitrification Field: No Fields 1 Square Feet 900 Linear Feet 300
No Lines 4@75' Trench Width 36" Max Trench Bottom Depth @ 30" Gravel Depth NA

☑ New System ☐ Repair System Type: I II III IV V VI
System Description: gravity chambered
Repair System Description: grav/pumped chambered
Maintenance Agreement Required: ☐ Yes ☑ No

☐ House/Mod. Home No. Bedrooms 3
☐ Mobile Home No. Bathrooms 2½
☐ Business No. Employees
☐ Other
☐ Slab ☑ Crawl Space ☐ Basement w/plumbing ☐ Basement wo/plumbing


Water Supply: ☑ Individual ☐ Community ☐ Public

Comments:

Comments: pretreat

1"=50'

INITIAL SITE SKETCH

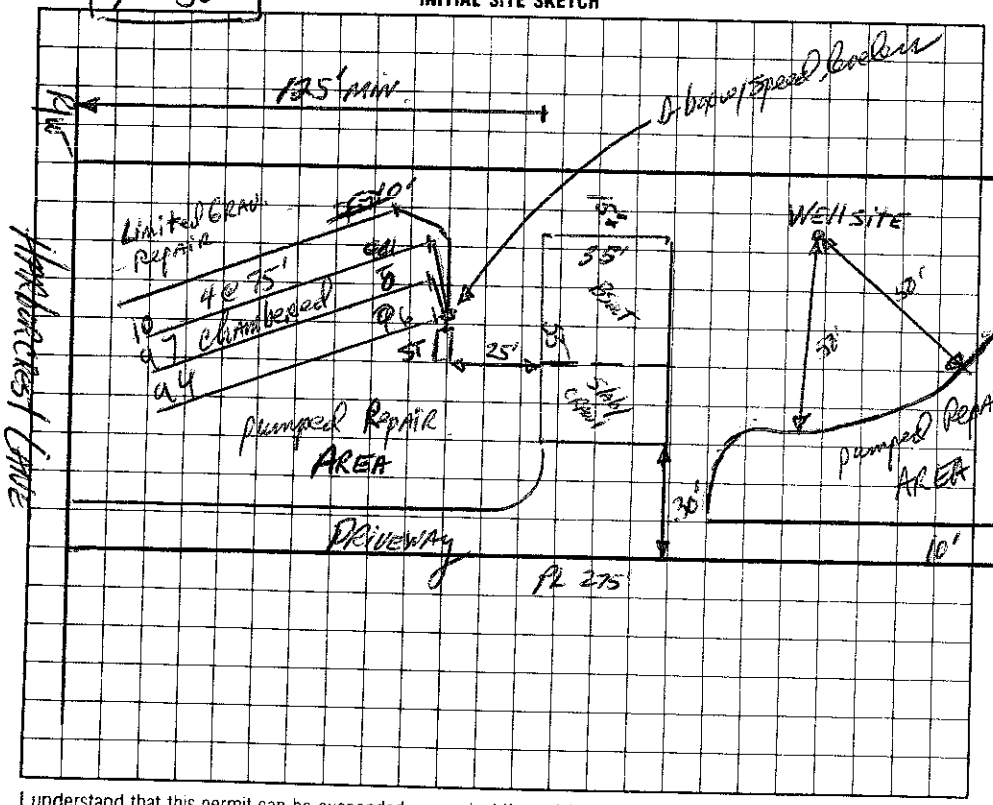

AS BUILT SKETCH

(NOTE: THIS IS LOT 15)
C. Mayton

I understand that this permit can be suspended or revoked if any false information is supplied toward securing the permit/any unauthorized changes are made to the site/any unauthorized changes are made in the installation of the system

Signed: Larry Hodges

Improvement Permit by: [signature] date 3-21-96

~~Existing System Inspection by:~~ Construction Authorization: [signature] date 3-21-96

Installed by: Thompson Earthworks

Certificate of Completion by: date

Operation Permit by: C. Mayton EHST date 5/24/96

HEALTH DEPT. COPY: WHITE INSPECTION COPY (FINAL): GREEN OWNER COPY (FINAL): YELLOW INSPECTION COPY (INITIAL): PINK OWNER COPY (INITIAL): GOLD