IREDELL COUNTY HEALTH DEPARTMENT

STATESVILLE 704-878-5305 MOORESVILLE 704-664-5281

IMPROVEMENT PERMIT / AUTHORIZATION TO CONSTRUCT / OPERATION PERMIT / EXISTING SYSTEM INSPECTION

PERMIT# 126556 PIN# 4637762039 DATE 3-17-05

OWNER OR CONTRACTOR Jeffrey Mays PHONE: Business 634-4575 Home

ADDRESS 113 Old Squaw Trail Mooresville, NC 28117

LOCATION Hwy 150 West TL Kendra at end on left 235 Kendra

SUBDIVISION Doolie Meadows BLOCK / SECTION LOT 26 LOT AREA .6027 Acre SITE CLASS. PS DESIGN FLOW 360gpd L.T.A.R. .3

Septic Tank: 1000 Gallons; STB T&T Date 9/26/05

Pump Tank: Gallons; PT Date

Pump Make: Model Serial No.

Nitrification Field: No Fields 1 Square Feet 1200' Linear Feet 400'

No Lines 5@80' Trench Width 36" Max Trench Bottom Depth 28" Gravel Depth 12"

☒ New System ☐ Repair System Type: I, II, III, IV, V, VI

System Description: Gravity Conventional

Repair System Description Gravity - 25% Reduction

Maintenance Agreement Required: ☒ Yes ☒ No

☒ House/Mod. Home No. Bedrooms 3

☐ Mobile Home No. Bathrooms 3

☐ Business No. Employees

☐ Other


☐ Slab ☒ Crawl Space ☐ Basement w/plumbing ☐ Basement wo/plumbing

Water Supply: ☐ Individual ☒ Public ☒ Community

Comments:/Conditions: Keep Septic System at least 10' to PL & 10' from house. Reviewed Floor plans 5/16/05, in compliance with I.P.

Comments:/Conditions: Note: Shallow placed drainfield for Repair. Okay to use Dist. box or drop boxes but keep LR ≤ 28".

Scale 1:50 INITIAL SITE SKETCH

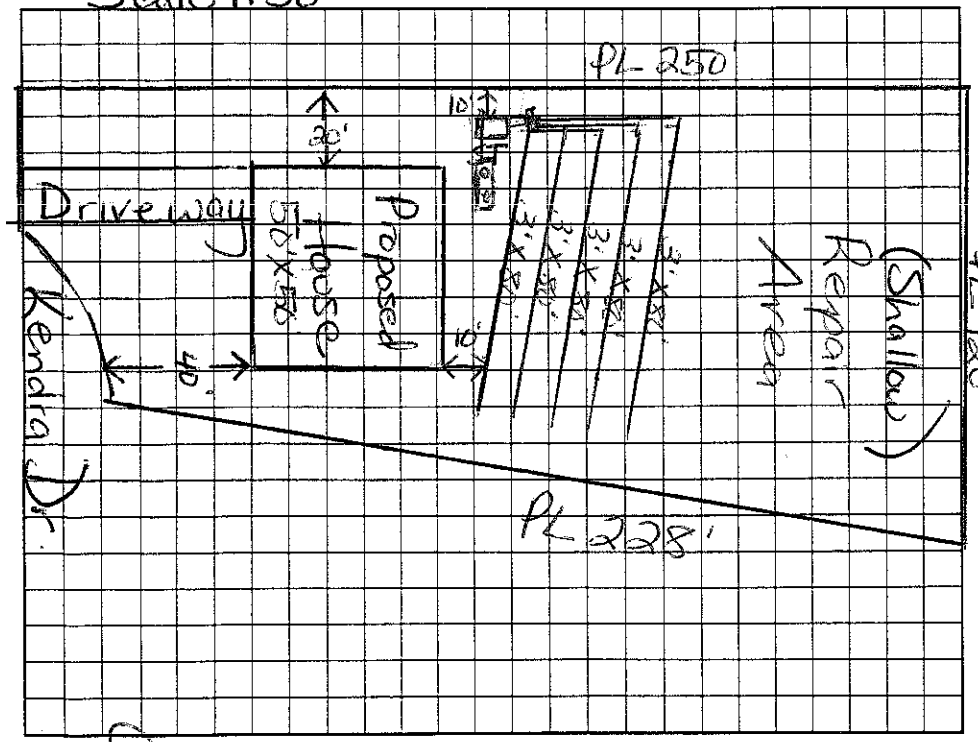

AS BUILT SKETCH

Accepted System + Inspection

Permit can be suspended or revoked if any false information is supplied toward securing the permit/any unauthorized changes are made to the site/any unauthorized changes are made in the installation of the system. Improvement Permit with plat valid without expiration. Improvement Permit with site plan valid for sixty months. Authorization to Construct is valid for a period equal to that of Improvement Permit – not to exceed sixty months.

Signed: date 3/8/05 Installed by: Ordison & Sons

Improvement Permit by: RS date 3/17/05 Operation Permit by: Wesley Sparks RS. date 11/1/05

Authorization to Construct by: RS date 5/16/05 Existing System Inspection by: date

HEALTH DEPT. COPY: WHITE OWNER COPY (FINAL): YELLOW OWNER COPY (INITIAL): PINK