(3.00)

IREDELL COUNTY HEALTH DEPARTMENT

STATESVILLE 704-878-5305 MOORESVILLE 704-664-5281

IMPROVEMENT PERMIT / AUTHORIZATION TO CONSTRUCT / OPERATION PERMIT / EXISTING SYSTEM INSPECTION

PERMIT# 235668 PIN# 4637 76 2139 DATE 5/4/98

OWNER OR CONTRACTOR Perry Jenkins PHONE: Business Home Bldr Keith Smith 363-5328

ADDRESS 2141 Old Mountain Rd Statesville NC 28677 Pg 954-5533

LOCATION Hwy 150 TL Kendra Near end on Right

SUBDIVISION Dooley Meadows BLOCK / SECTION LOT 27 LOT AREA 25,000 sq ft SITE CLASS. PS DESIGN FLOW 360 gpd L.T.A.R. .3

Septic Tank: 1000 Gallons; STB 714 Date 4/26/98
Pump Tank: Gallons; PT Date
Pump Make: Model Serial No.
Nitrification Field: No Fields 1 Square Feet 1200' Linear Feet 400'
No Lines 5 at 80' Trench Width 36" Max Trench Bottom Depth 20"

☒ New System ☐ Repair System Type: I, (II), III, IV, V, VI
System Description: Gravity - Conventional
Repair System Description: Same
Maintenance Agreement Required: ☐ Yes ☒ No
Gravel Depth 12" ☐ Slab ☒ Crawl Space ☐ Basement w/plumbing ☐ Basement wo/plumbing


☒ House/Mod. Home No. Bedrooms 3
☐ Mobile Home No. Bathrooms 2
☐ Business No. Employees
☐ Other

Water Supply: ☐ Individual ☐ Public ☒ Community

Comments:/Conditions (House sits 75' from Street)
Keep Septic System 5' from House & 10' From PL.

Comments:/Conditions:

INITIAL SITE SKETCH Scale 1:50

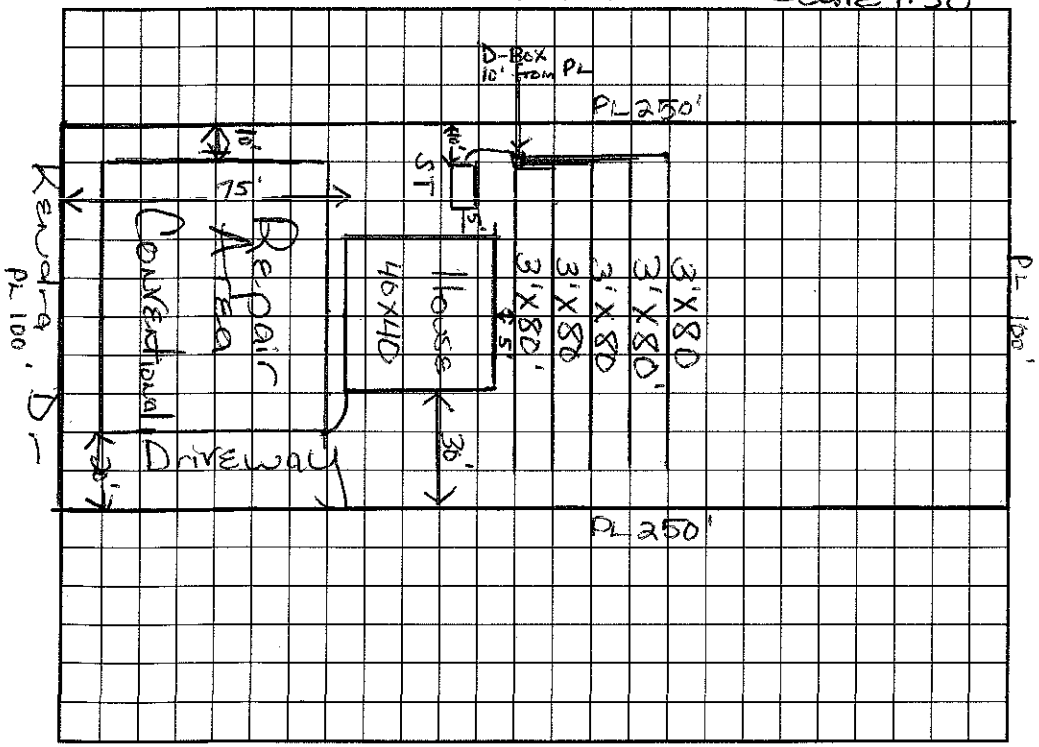

AS BUILT SKETCH

I understand that this permit can be suspended or revoked if any false information is supplied toward securing the permit/any unauthorized changes are made to the site/any unauthorized changes are made in the installation of the system. Improvement Permit with plat valid without expiration. Improvement Permit with site plan valid for sixty months. Authorization to Construct is valid for a period equal to that of Improvement Permit – not to exceed sixty months.

Signed: Ray Short date 8/21/98

Improvement Permit by: Maria H. Dotson date 5/4/98

Authorization to Construct by: Maria H. Dotson date 5/4/98

Installed by: PJJ Jenkins

Operation Permit by: R. Dotson / C. date 11/23/98

Existing System Inspection by: date

HEALTH DEPT. COPY: WHITE INSPECTION COPY (FINAL): GREEN OWNER COPY (FINAL): YELLOW INSPECTION COPY (INITIAL): PINK OWNER COPY (INITIAL): GOLD