As Built

IREDELL COUNTY HEALTH DEPARTMENT

STATESVILLE 704-878-5305 MOORESVILLE 704-664-5281

IMPROVEMENT PERMIT / AUTHORIZATION TO CONSTRUCT / OPERATION PERMIT / EXISTING SYSTEM INSPECTION

PERMIT# 130351 PIN# ~~4637762349~~ 4637762413 DATE 3-3-06

OWNER OR APPLICANT David Curescu PHONE: Business _____ Home _____

ADDRESS _____

LOCATION _____

SUBDIVISION Doolie Meadows BLOCK / SECTION _____ LOT 29 LOT AREA _____ SITE CLASS. PS DESIGN FLOW 360gpd T.A.R. .3

Septic Tank: 1000 Gallons: STB 1007 Date 11-8-05
Pump Tank: _____ Gallons: PT _____ Date _____
Pump Make: _____ Model _____ Serial No. _____
Nitrification Field: No Fields 1 Square Feet 900 Linear Feet 300
No Lines 4@75' Trench Width 36" Max Trench Bottom Depth 36" Gravel Depth N/A

☒ New System ☐ Repair ☐ Expansion System Type: I II III IV V VI
System Description: Gravity - Accepted
Repair System Description: Same
Maintenance Agreement Required: ☐ Yes ☒ No
☐ Gravity ☐ Pressure

☒ House/Mod. Home No. Bedrooms 3
☐ Mobile Home No. Persons ___
☐ Business No. Employees ___
☐ Other _____


Water Supply: ☐ Individual ☐ Public ☒ Community

☐ Slab ☐ Crawl Space ☐ Basement w/plumbing ☐ Basement wo/plumbing


Comments:/Conditions:

Comments:/Conditions:

INITIAL SITE SKETCH

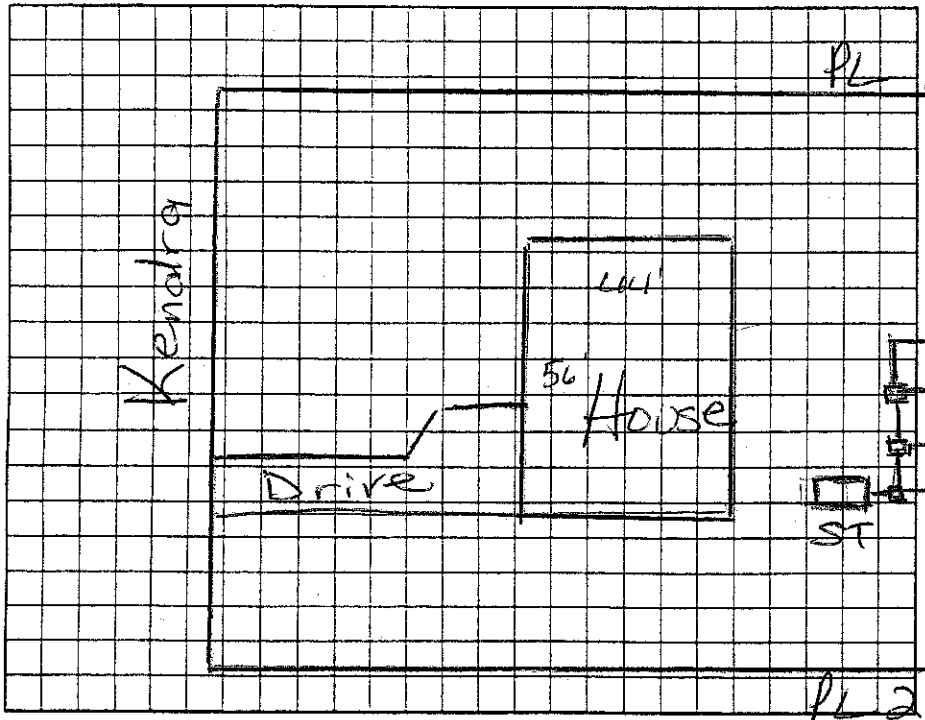

AS BUILT SKETCH

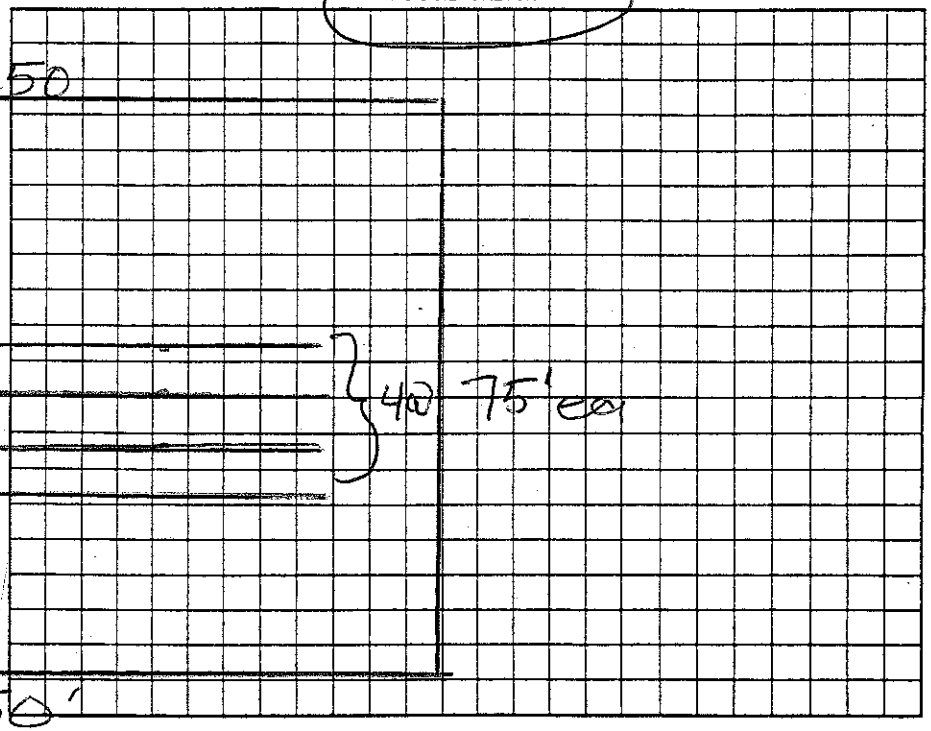

Permit can be suspended or revoked if any false information is supplied toward securing the permit/any unauthorized changes are made to the site/any unauthorized changes are made in the installation of the system. Improvement Permit with plat valid without expiration ☐ Improvement Permit with site plan valid for sixty months ☐ Authorization to Construct is valid for a period equal to that of Improvement Permit – not to exceed sixty months.

Signed: _____ date _____ Installed by: Wayne Glontz

Improvement Permit by: _____ date _____ Operation Permit by: Melissa Hall date _____

Authorization to Construct by: _____ date _____ Existing System Inspection by: _____ date _____

HEALTH DEPT. COPY: WHITE OWNER COPY (FINAL): YELLOW OWNER COPY (INITIAL): PINK

IREDELL COUNTY HEALTH DEPARTMENT

STATESVILLE 704-878-5305 MOORESVILLE 704-664-5281

2:30

IMPROVEMENT PERMIT / AUTHORIZATION TO CONSTRUCT / OPERATION PERMIT / EXISTING SYSTEM INSPECTION

PERMIT# 130351 PIN# 4637-76-~~2347~~ 2413 DATE 8/30/05

OWNER OR CONTRACTOR David Curescu PHONE: Business 704 526-5799 Home 704-664 7796

ADDRESS 120 Julius Ln Mooresville NC.

LOCATION 150 W TL Kendra, on Lt

SUBDIVISION Doolie Meadows BLOCK / SECTION ____ LOT 29 LOT AREA 30,000Ft² SITE CLASS. PS DESIGN FLOW 360 L.T.A.R. 0.3

Septic Tank: 1000 Gallons; STB 1007 Date 11-8-05
Pump Tank: ____ Gallons; PT ____ Date ____
Pump Make: ____ Model ____ Serial No. ____
Nitrification Field: No Fields 1 Square Feet 1200 Linear Feet 400
No Lines 4@100' Trench Width 36" Max Trench Bottom Depth 36" Gravel Depth 12"

☒ New System ☐ Repair System Type: I, II, III, IV, V, VI
System Description: Gravity Conventional same Accepted
Repair System Description: ____
Maintenance Agreement Required: ☐ Yes ☒ No


☒ House/Mod. Home No. Bedrooms 3
☐ Mobile Home No. Bathrooms ____
☐ Business No. Employees ____
☐ Other ____
☐ Slab ☒ Crawl Space ☐ Basement w/plumbing ☐ Basement wo/plumbing

Water Supply: ☐ Individual ☐ Public ☒ Community


Comments:/Conditions:
1"=40'
Checked ST 2/15/06 & 3 of 4 lines
4th line 2/16/06

Comments:/Conditions: Installed "Accepted" Plastic Chambers (Quick 4)

INITIAL SITE SKETCH

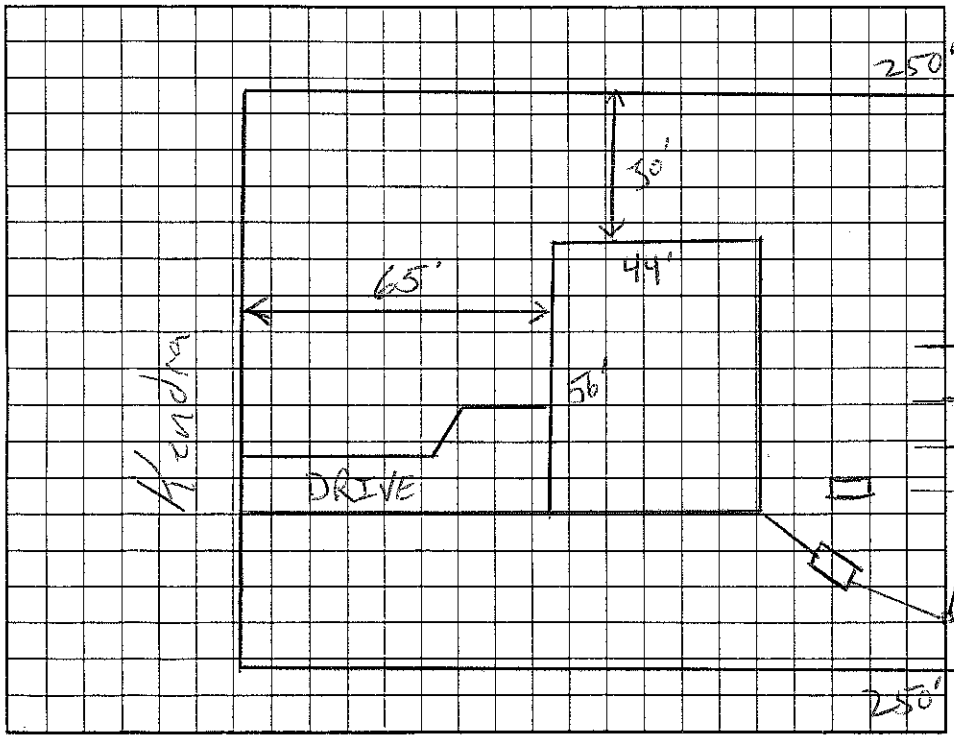

AS BUILT SKETCH

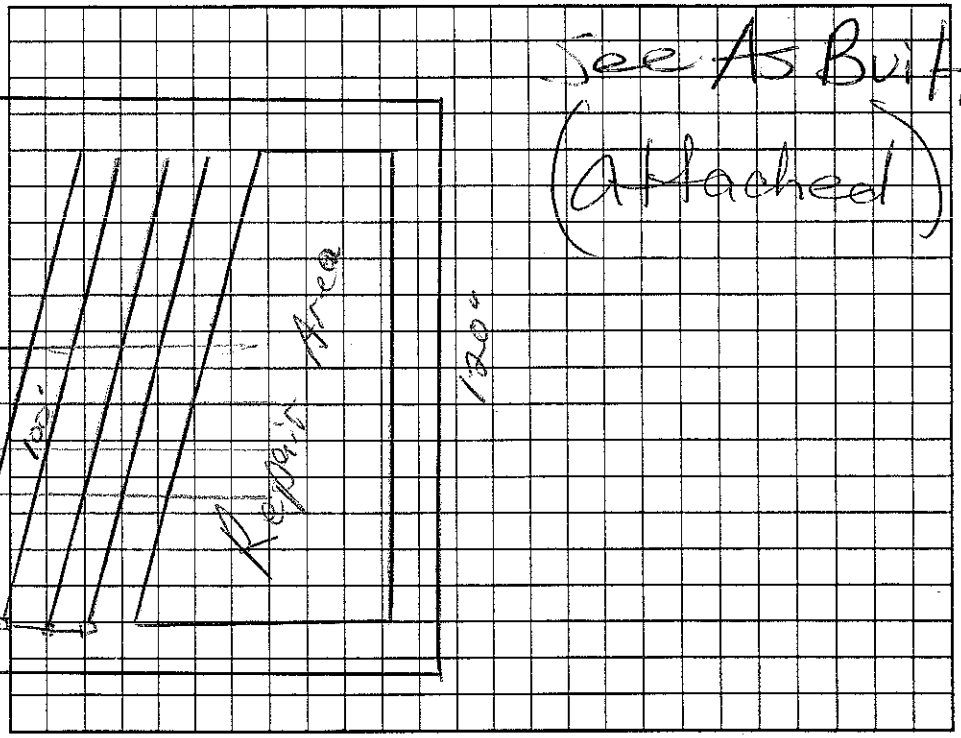

Permit can be suspended or revoked if any false information is supplied toward securing the permit/any unauthorized changes are made to the site/any unauthorized changes are made in the installation of the system. Improvement Permit with plat valid without expiration. Improvement Permit with site plan valid for sixty months. Authorization to Construct is valid for a period equal to that of Improvement Permit – not to exceed sixty months.

Signed: David Curescu date 8-30-05 Installed by: Wayne Clontz (Janie's Grading)

Improvement Permit by: RS date 8/30/05 Operation Permit by: RS date 2/16/06

Authorization to Construct by: RS date 8/30/05 Existing System Inspection by: ____ date ____

HEALTH DEPT. COPY: WHITE OWNER COPY (FINAL): YELLOW OWNER COPY (INITIAL): PINK