IREDELL COUNTY HEALTH DEPARTMENT

STATESVILLE 704-878-5305 MOORESVILLE 704-664-5281

IMPROVEMENT PERMIT / AUTHORIZATION TO CONSTRUCT / OPERATION PERMIT / EXISTING SYSTEM INSPECTION

PERMIT# 130350 PIN# 4637 76 2854 DATE 9/14/05

OWNER OR CONTRACTOR Cornel Crisan PHONE: Business _____ Home _____

ADDRESS 6800 N. Tripp Av. Lincolnwood IL 60712

LOCATION 150 W TL Kendra, on Lt.

SUBDIVISION Doolie Meadows BLOCK / SECTION _____ LOT 033 LOT AREA 25,000 sqft SITE CLASS. 360 DESIGN FLOW PS L.T.A.R. 0.3

Septic Tank: 1000 Gallons; STB 1007 Date 2-1-07
Pump Tank: _____ Gallons; PT _____ Date _____
Pump Make: _____ Model _____ Serial No. _____
Nitrification Field: No Fields 1 Square Feet 900 Linear Feet 300
No Lines 4@75' Trench Width 36" Max Trench Bottom Depth 36" Gravel Depth —

☒ New System ☐ Repair System Type: I, II, III, IV, V, VI
System Description: Gravity 25% Reduction
Repair System Description: Pump Panel Block
Maintenance Agreement Required: ☐ Yes ☒ No

☒ House/Mod. Home No. Bedrooms 3
☐ Mobile Home No. Bathrooms ____
☐ Business No. Employees ____
☐ Other _____

☐ Slab ☒ Crawl Space ☐ Basement w/plumbing ☐ Basement wo/plumbing


Water Supply:
☐ Individual
☐ Public
☒ Community

Comments:/Conditions: Remove all Berms


1"=40'

Comments:/Conditions: Installed Quick 4 Drainfield

INITIAL SITE SKETCH

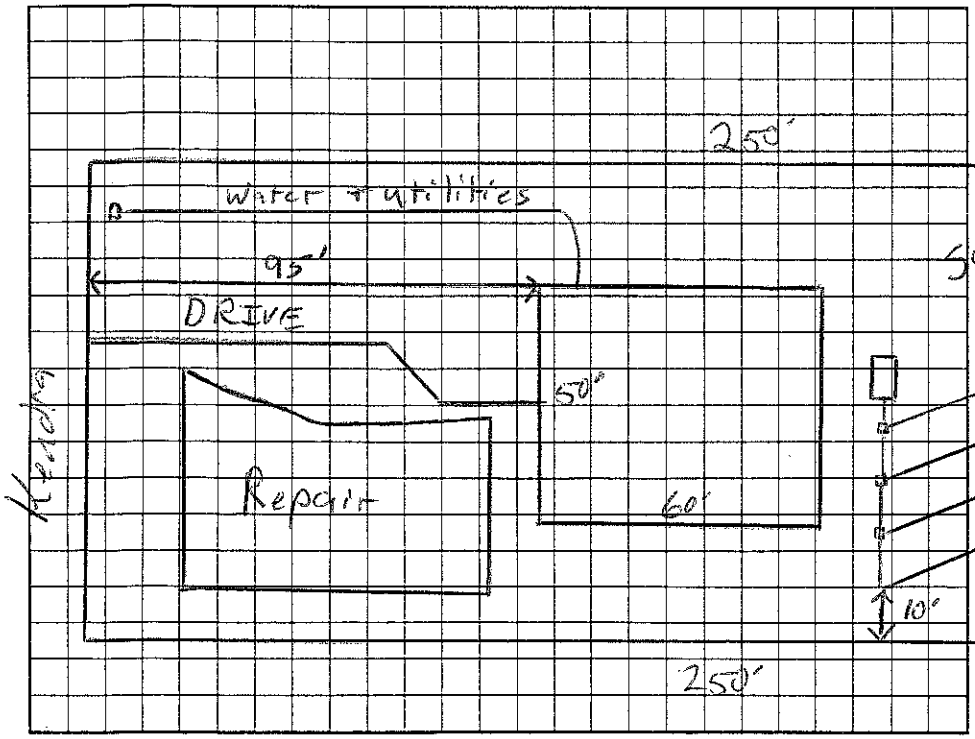

AS BUILT SKETCH

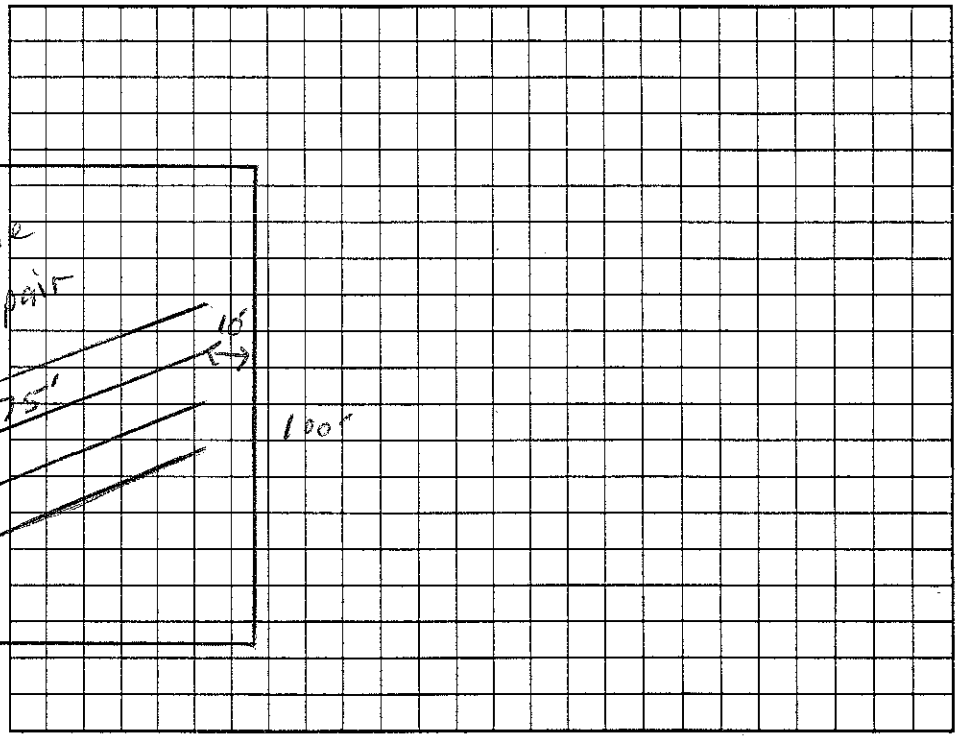

Permit can be suspended or revoked if any false information is supplied toward securing the permit/any unauthorized changes are made to the site/any unauthorized changes are made in the installation of the system. Improvement Permit with plat valid without expiration. Improvement Permit with site plan valid for sixty months. Authorization to Construct is valid for a period equal to that of Improvement Permit – not to exceed sixty months.

Signed: Ioan Crisan date 09/10/05 Installed by: Wayne Glontz RS

Improvement Permit by: RS date 9/14/05 Operation Permit by: RS date 3/24/07

Authorization to Construct by: RS date 9/14/05 Existing System Inspection by: _____ date _____

HEALTH DEPT. COPY: WHITE OWNER COPY (FINAL): YELLOW OWNER COPY (INITIAL): PINK