Auth. to Construct PIN#4637-76-2954 3:00

IREDELL COUNTY HEALTH DEPARTMENT

STATESVILLE 704-878-5305 MOORESVILLE 704-664-5281

IMPROVEMENT PERMIT / ~~CERTIFICATE OF COMPLETION~~ / OPERATION PERMIT / EXISTING SYSTEM INSPECTION

PROPERTY DESCRIPTION NO. 067584 DATE 6/20/97 TAX MAP NO. 4637782465 PT Watershed: ☒ Yes ☐ No

OWNER OR CONTRACTOR Mike Short PHONE: ~~Business~~ Pager 337-3952 Home (704) 598-5866

ADDRESS 9005 NE Harris Blvd Charlotte, NC 28227

LOCATION Hwy 150 TR TL Kendra Dr. 1/2 way down on RT LT

SUBDIVISION Deer Meadows BLOCK / SECTION ____ LOT 34 LOT AREA ____ SITE CLASS. PS DESIGN FLOW 360 gpd L.T.A.R. .54

Septic Tank: 1000 Gallons; STB 794 Date 7/14/97
Pump Tank: ____ Gallons; PT ____ Date ____
Pump Make: ____ Model ____ Serial No. ____
Nitrification Field: No Fields 2 Square Feet 1200 Linear Feet 400'
No Lines 8 at 50' Trench Width 36" Max Trench Bottom Depth 36" Gravel Depth 12"

☒ New System ☐ Repair System Type: I, II, III, IV, V, VI
System Description: Gravity - Conventional
Repair System Description: Pump - Modified
Maintenance Agreement Required: ☐ Yes ☒ No

☒ House/Mod. Home No. Bedrooms 3
☐ Mobile Home No. Bathrooms 2
☐ Business No. Employees ____
☐ Other ____


☐ Slab ☒ Crawl Space ☐ Basement w/plumbing ☐ Basement wo/plumbing

Water Supply:
☐ Individual
☒ Community
☐ Public

Comments:

Comments:

INITIAL SITE SKETCH Scale 1:50

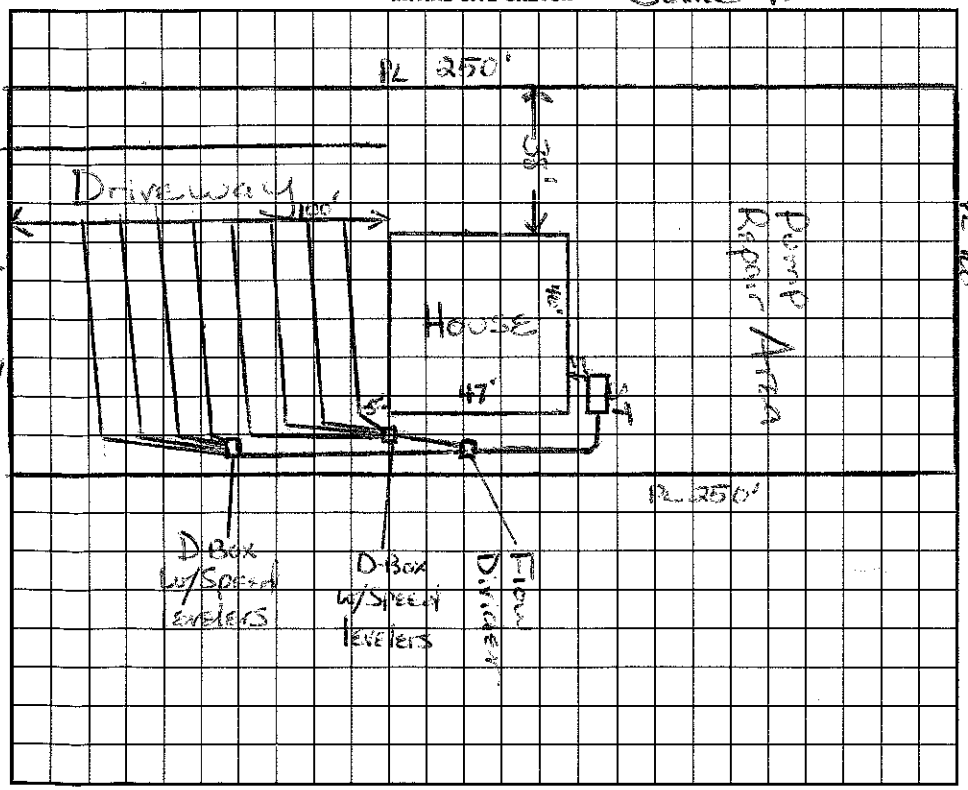

AS BUILT SKETCH

SAME AS SITE SKETCH

I understand that this permit can be suspended or revoked if any false information is supplied toward securing the permit/any unauthorized changes are made to the site/any unauthorized changes are made in the installation of the system. Improvement Permit is valid for 60 months from date of issuance.

Signed: ____

Installed by: Larry Tucker

~~nt~~ Permit by: Maria H. Watson date 6/20/97

~~ction~~ by: Maria H. Watson date 6/20/97

Certificate of Completion by: ____ date ____

Operation Permit by: C. [illegible] date 9/2/97

WHITE COPY: WHITE INSPECTION COPY (FINAL): GREEN OWNER COPY (FINAL): YELLOW INSPECTION COPY (INITIAL): PINK OWNER COPY (INITIAL): GOLD