PIN#4637-77-2074

IREDELL COUNTY HEALTH DEPARTMENT

STATESVILLE 704-878-5305 MOORESVILLE 704-664-5281

IMPROVEMENT PERMIT / CERTIFICATE OF COMPLETION / OPERATION PERMIT / EXISTING SYSTEM INSPECTION

PROPERTY DESCRIPTION NO. 23559 DATE 11/17/97 TAX MAP NO. 2P-D-35 Watershed: ☐ Yes ☐ No

OWNER OR CONTRACTOR Robert C. Maier PHONE: Business (919) 280-0047 Home (919) 557-8157

ADDRESS 903 Magnolia Ridge Way Fuquay-Varina NC 27526

LOCATION 150 Lw Pl Kendra Dr on left ~ 1/3 mile

SUBDIVISION Doolie Meadows BLOCK / SECTION _____ LOT 35 LOT AREA 25,000 SITE CLASS. PS DESIGN FLOW 360gpd L.T.A.R. e 34

Septic Tank: 1600 Gallons; STB 794 Date 11/26/97 ☒ New System ☐ Repair System Type: I, II, III, IV, V, VI

Pump Tank: _____ Gallons; PT _____ Date _____ System Description: Engr Conventional

Pump Make: _____ Model _____ Serial No. _____ Repair System Description: Pump Conventional

Nitrification Field: No Fields 1 Square Feet 1200 Linear Feet 400 Maintenance Agreement Required: ☐ Yes ☐ No

No Lines 8 at 50' Trench Width 36" Max Trench Bottom Depth 36" Gravel Depth 12"

☒ House/Mod. Home No. Bedrooms 3

☐ Mobile Home No. Bathrooms 2

☐ Business No. Employees _____

☐ Other _____


☐ Slab ☐ Crawl Space ☐ Basement w/plumbing ☐ Basement wo/plumbing

Water Supply: ☐ Individual ☒ Community ☐ Public

Comments: Install lines on contour

Comments:

INITIAL SITE SKETCH Scale 1:50

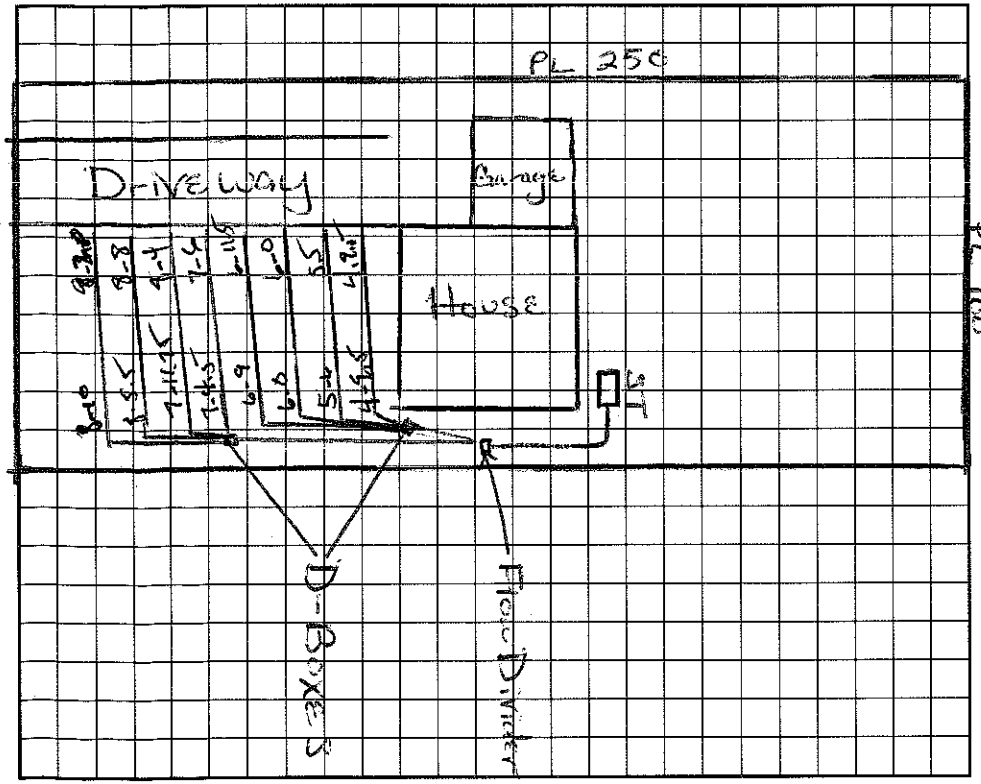

AS BUILT SKETCH

I understand that this permit can be suspended or revoked if any false information is supplied toward securing the permit/any unauthorized changes are made to the site/any unauthorized changes are made in the installation of the system. Improvement Permit is valid for 60 months from date of issuance.

Signed: Robert Maier

Improvement Permit by: Marsha H. Hatcher date 11/17/97

System Inspection by: Marsha H. Hatcher date 11/17/97

Installed by: Norman Roach

Certificate of Completion by: Wesley Sparks RS date 3/2/98

Operation Permit by: Wesley Sparks RS. date 3/2/98

HEALTH DEPT. COPY: WHITE INSPECTION COPY (FINAL): GREEN OWNER COPY (FINAL): YELLOW INSPECTION COPY (INITIAL): PINK OWNER COPY (INITIAL): GOLD