PIN# 4637-77-2164

IREDELL COUNTY HEALTH DEPARTMENT

STATESVILLE 704-878-5305 MOORESVILLE 704-664-5281

IMPROVEMENT PERMIT / CERTIFICATE OF COMPLETION / OPERATION PERMIT / EXISTING SYSTEM INSPECTION

PROPERTY DESCRIPTION NO. 23558 DATE 7/8/97 TAX MAP NO. 2P-D-36 Watershed: ☒ Yes ☐ No

OWNER OR CONTRACTOR Pamela Brigh Hall PHONE: Business _____ Home 662-3948

ADDRESS 1530 Sheagers Rd Mooresville NC 28115

LOCATION 150 W TL Kendra Dr 7th lot on left

SUBDIVISION Deelie Meadows BLOCK / SECTION _____ LOT 36 LOT AREA 25,000 sq ft SITE CLASS. PS DESIGN FLOW 3 Bdrm L.T.A.R. .3

Septic Tank: 1000 Gallons; STB 794 Date 8/29/97

Pump Tank: _____ Gallons; PT _____ Date _____

Pump Make: _____ Model _____ Serial No. _____

Nitrification Field: No Fields 1 Square Feet 1206 Linear Feet 402

No Lines 6 at 67' Trench Width 36" Max Trench Bottom Depth 24-36" Gravel Depth 12"

☒ New System ☐ Repair System Type: I, (II), III, IV, V, VI

System Description: Gravel Conventional

Repair System Description: Gravel / Pump Final Bldg

Maintenance Agreement Required: ☐ Yes ☒ No

☒ House/Mod. Home ☐ Mobile Home ☐ Business ☐ Other

No. Bedrooms 3 No. Bathrooms 2 No. Employees _____


☐ Slab ☒ Crawl Space ☐ Basement w/plumbing ☐ Basement wo/plumbing

Water Supply: ☐ Individual ☒ Community ☐ Public

Comments: Keep Septic tank & lines at least 5Ft from house & 10 Ft from Property line.

Comments:

INITIAL SITE SKETCH Scale = 1:50

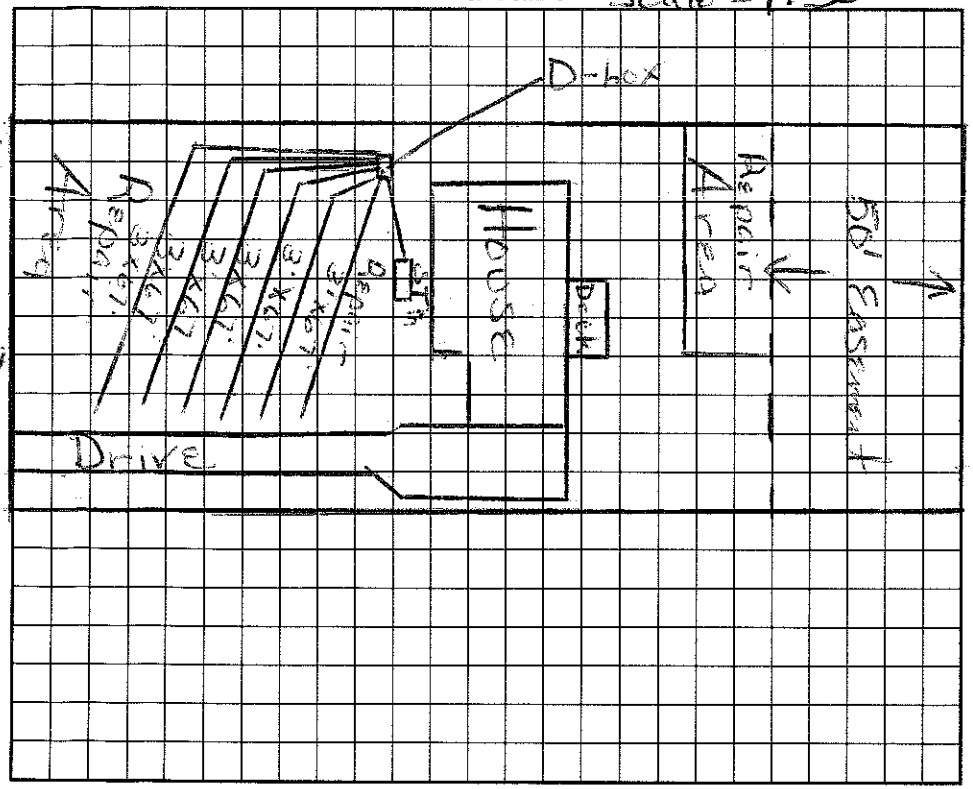

AS BUILT SKETCH

I understand that this permit can be suspended or revoked if any false information is supplied toward securing the permit/any unauthorized changes are made to the site/any unauthorized changes are made in the installation of the system. Improvement Permit is valid for 60 months from date of issuance.

Signed: Pamela Brigh Hall

Improvement Permit by: Westley Sparks R.S. date 7/8/97

Existing System Inspection by: Westley Sparks R.S. date 7/8/97

Installed by: Dwight Posey

Certificate of Completion by: Westley Sparks R.S. date 11/25/97

Operation Permit by: Westley Sparks R.S. date 11/25/97

HEALTH DEPT. COPY: WHITE / INSPECTION COPY (FINAL): GREEN OWNER COPY (FINAL): YELLOW INSPECTION COPY (INITIAL): PINK OWNER COPY (INITIAL): GOLD