PIN # 4637-78-2068

# IREDELL COUNTY HEALTH DEPARTMENT

STATESVILLE 704-878-5305 MOORESVILLE 704-664-5281

## IMPROVEMENT PERMIT / CERTIFICATE OF COMPLETION / OPERATION PERMIT / EXISTING SYSTEM INSPECTION

PROPERTY DESCRIPTION NO. 25233 DATE 9/25/96 TAX MAP NO. 2P 16 A 114 Watershed: [X] Yes [ ] No

OWNER OR CONTRACTOR Sun Wood Bldg PHONE: Business 872-0922 Home

ADDRESS PO Box 5871 Statesville, NC. 28115

LOCATION 150 W TL Kendrick, ~600 on LT

SUBDIVISION Doolie Meadows BLOCK / SECTION LOT 44 LOT AREA 105 x 210' SITE CLASS. PS DESIGN FLOW 360 L.T.A.R. .3

Septic Tank: 1000 Gallons; STB 1012 Date 8-5-96
Pump Tank: Gallons; PT Date
Pump Make: Model Serial No.
Nitrification Field: No Fields 1 Square Feet 1200 Linear Feet 400
No Lines 5 Trench Width 36" Max Trench Bottom Depth 36" Gravel Depth 12"

[X] New System [ ] Repair System Type: I (II) III, IV, V, VI
System Description: CONV - DIST BOX
Repair System Description: SAME
Maintenance Agreement Required: [ ] Yes [X] No


[X] House/Mod. Home No. Bedrooms 3
[ ] Mobile Home No. Bathrooms 2
[ ] Business No. Employees
[ ] Other
[ ] Slab [X] Crawl Space [ ] Basement w/plumbing [ ] Basement wo/plumbing

Water Supply: [ ] Individual [X] Community [ ] Public


Comments:

Comments: Contour different than shown on initial sketch. Laterals on contour

INITIAL SITE SKETCH

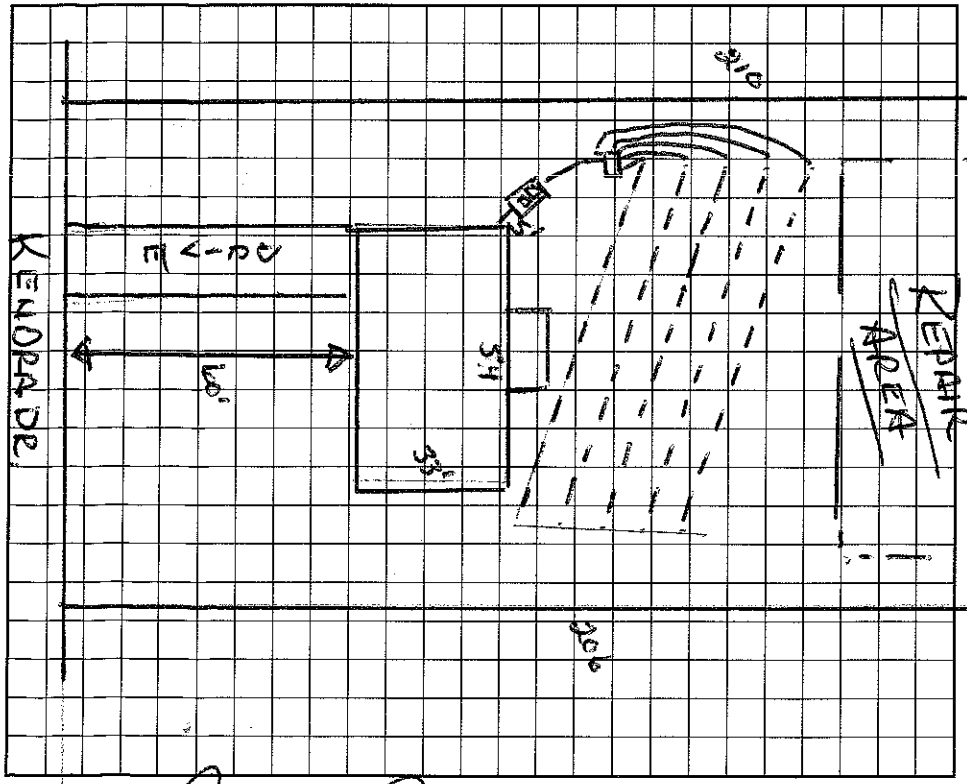


AS BUILT SKETCH

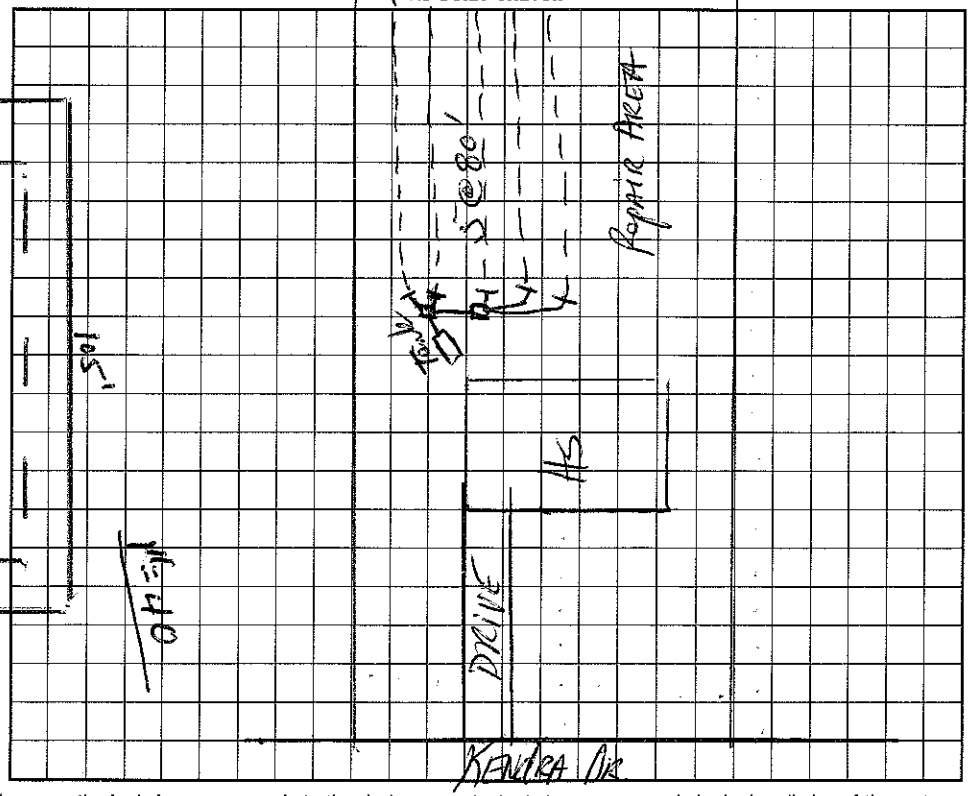


I understand that this permit can be suspended or revoked if any false information is supplied toward securing the permit/any unauthorized changes are made to the site/any unauthorized changes are made in the installation of the system.

Signed: [signature]

Improvement Permit by: Wesley Sparks R.S. date 9/25/96

Existing System Inspection by: Wesley Sparks R.S. date 9/25/96

Installed by: Tommy Gryg

Certificate of Completion by: date

Operation Permit by: [signature] R.S. date 11-22-96

HEALTH DEPT. COPY: WHITE INSPECTION COPY (FINAL): GREEN OWNER COPY (FINAL): YELLOW INSPECTION COPY (INITIAL): PINK OWNER COPY (INITIAL): GOLD