IREDELL COUNTY HEALTH DEPARTMENT

Statesville Office (704) 878-5305 Mooresville Office (704) 660-3625 PERMIT # 215465

IMPROVEMENT PERMIT / AUTHORIZATION TO CONSTRUCT / OPERATION PERMIT / EXISTING SYSTEM

PIN # 4637809044

APPLICANT: Chittenden Properties LLC APPLICANT ADDRESS: 14311 Hunters Rd Mooresville NC

SITE ADDRESS: 835 Brawley School Rd, Mocksville PHONE: ALT. PHONE:

SITE DIRECTIONS: Brawley School Rd- on LT just before Canvasback Rd

SUBDIVISION: Floyd E. Green SECTION: — LOT # — LOT AREA: 1.81 AC DESIGN FLOW: 240 L.T.A.R.: Existing

Septic Tank (gal) STB Date

Pump Tank (gal) PT Date

Pump Make Model 3HP 3 PHASE Serial #

Nitrification Fields # Lines Linear Ft:

Trench Width Max. Trench Bottom Depth Gravel Depth

☑ New System ☐ Repair ☐ Expansion System Type: I II III IV V VI

System Description: GRAVITY BED

Repair System Description: SAME

Maintenance Agreement Required: ☐ YES ☑ NO

☑ GRAVITY ☐ PRESSURE

☑ Residence No. Bedrooms

☑ Business No. Persons

☐ Other No. Employees 9

☑ Slab ☐ Crawl Space

☐ Basement w/plumbing ☐ Basement w/o plumbing

Water Supply

☐ Private

☑ Public

☐ Community

Comments / Conditions: FOR 5000 SQ FT STORAGE & 9 EMPLOYEES. NO RETAIL SPACE.

INITIAL SITE SKETCH

See Michael Thomas & Associates Design.

AS BUILT SKETCH

Permit can be suspended or revoked if any false information is supplied toward securing the permit / any unauthorized changes are made to the site / any unauthorized changes are made in the installation of the system. **CONTACT A LOCATOR SERVICE PRIOR TO ANY EXCAVATION**

☐ **IMPROVEMENT PERMIT** *with plat valid without expiration.* ☐ **IMPROVEMENT PERMIT** *with site plan valid for 60 mos.* ☐ **AUTHORIZATION TO CONSTRUCT** *valid for period equal to IMPROVEMENT PERMIT--not to exceed 60 mo.*

Owner / Applicant Signature: Date: Installed by:

IMPROVEMENT PERMIT by: Date: 9/2/16 OPERATION PERMIT by: Date:


AUTHORIZATION TO CONSTRUCT by: Date: Existing System Inspected by: Date: 8/31/16


Health Dept. Copy - WHITE Applicant (Final Approval) - YELLOW Applicant (Conditional Approval) - PINK

book 55, page 8, that the ratio of precision is 1':10,000, that this map was prepared in accordance with the General Statutes of North Carolina Chapter 89C. my hand and seal on the 18 day of AUG. A.D. 20 16

WILLIAM M. ALLEN, PLS

NORTH CAROLINA PROFESSIONAL SEAL L3499 LAND SURVEYOR WILLIAM M. ALLEN

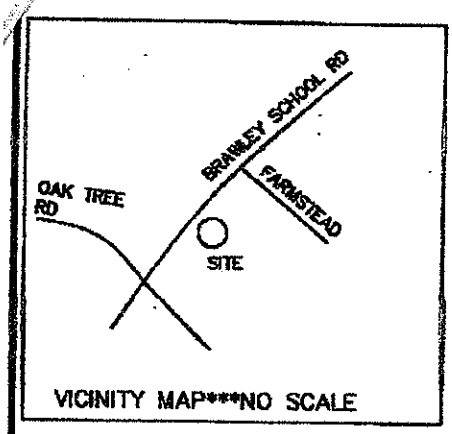


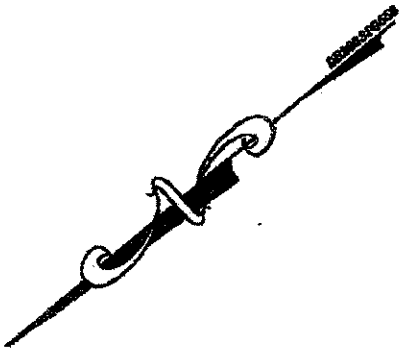

SWIM LAWN & LANDSCAPE LLC
2419\1749

LICENSED SOIL SCIENTIST MICHAEL ATHANAS 1252 STATE OF NORTH CAROLINA

MP LEASING LLP
2357\1886

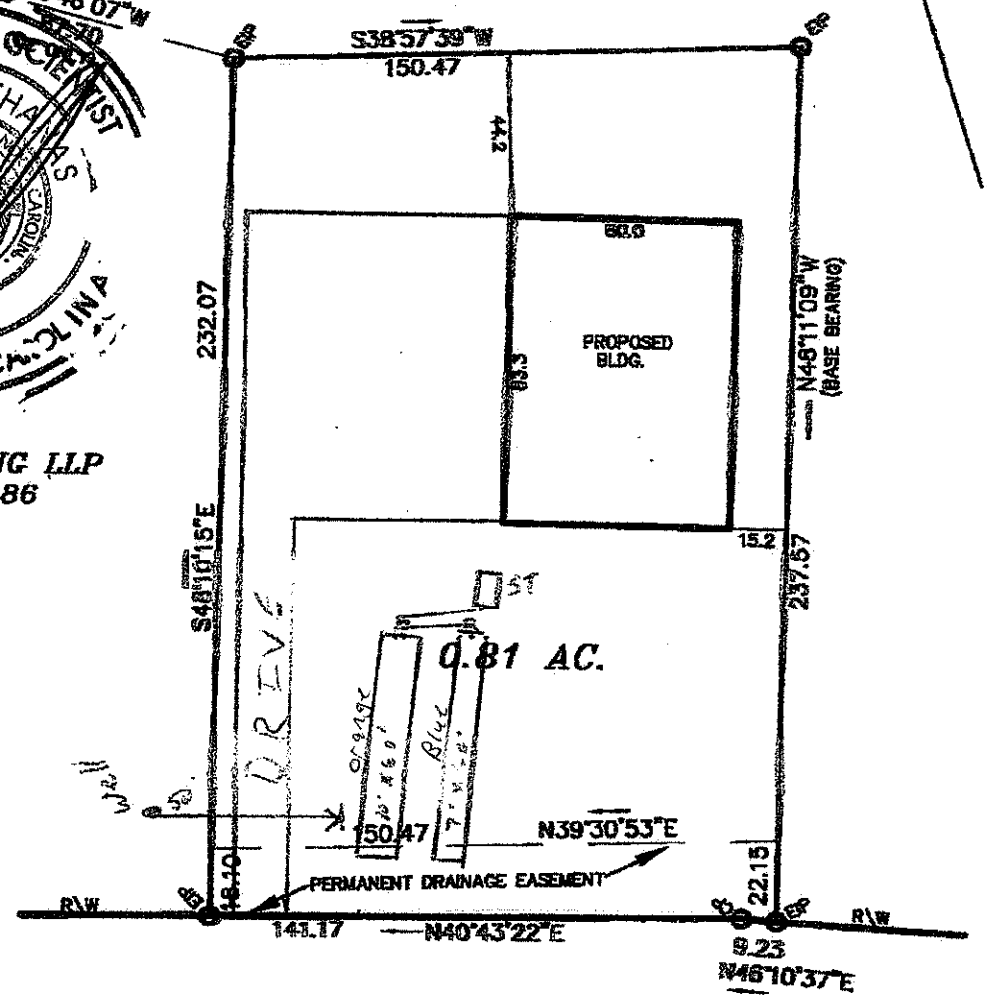

Scale 1"=50'

BRAWLEY SCHOOL RD.
(PUBLIC R\W WIDTH VARIES)

LEGEND

- P.P. = POWER POLE
- □ = POWER TRANS.
- E.I.P. = EXISTING IRON FOUND
- I.P.S. = #4 REBAR SET
- R/W = RIGHT-OF-WAY
- CP = COMPUTED POINT

NOTES

1) THIS PROPERTY MAY BE SUBJECT TO ANY EASEMENTS AND/OR RIGHTS OF WAY OF RECORD.
2) ACREAGE COMPUTED BY THE COORDINATE METHOD.
3) UNDERGROUND POWER
4) NO GRID MONUMENT FOUND WITHIN 2000 FEET.