4637809530

IREDELL COUNTY HEALTH DEPARTMENT

STATESVILLE 704-878-5305 MOORESVILLE 704-664-5281

IMPROVEMENT PERMIT / CERTIFICATE OF COMPLETION / OPERATION PERMIT / EXISTING SYSTEM INSPECTION

PROPERTY DESCRIPTION NO. 16396 DATE May 19, '95 TAX MAP NO. 2K21A1 Watershed:

OWNER OR CONTRACTOR Bonanza Development Co. PHONE: Business 365-2300 Home

ADDRESS 6827 C. Fairview Rd, Charlotte NC

LOCATION Brawley Sch Rd. on Right @ jct w/ Promenade Lane

SUBDIVISION BLOCK / SECTION LOT LOT AREA 30,000ft²+ SITE CLASS. PS per 1996 DESIGN FLOW 550gpd L.T.A.R. ~3

Septic Tank (EX) 1500 Gallons; STB Date

Pump Tank: Gallons; PT Date

Pump Make: Model Serial No.

Nitrification Field: No Fields Square Feet 300 + 600EX Linear Feet 100 + 534EX

No Lines 1+5EX Trench Width 36" Max Trench Bottom Depth 36" Gravel Depth 12"

☐ New System ☐ Repair System Type: I, II, (III) IV, V, VI

System Description: gravity conventional

Repair System Description: LP PPBPS

Maintenance Agreement Required: ☐ Yes ☐ No

☐ House/Mod. Home No. Bedrooms

☐ Mobile Home No. Bathrooms

☑ Business No. Employees 22

☑ Other Commercial bld - retail & office


☐ Slab ☐ Crawl Space ☐ Basement w/plumbing ☐ Basement wo/plumbing

Water Supply:
☑ Individual
☐ Community
☐ Public

Comments: New/additional Lateral may require replacement of existing 0-box if there is not an additional outlet in this box. A minimum of one cleanout per 50' on outfall line from commercial bld to EX tank on lot 4.

Comments: 90' installed in new trench for total of ~624'; ~612' required

INITIAL SITE SKETCH

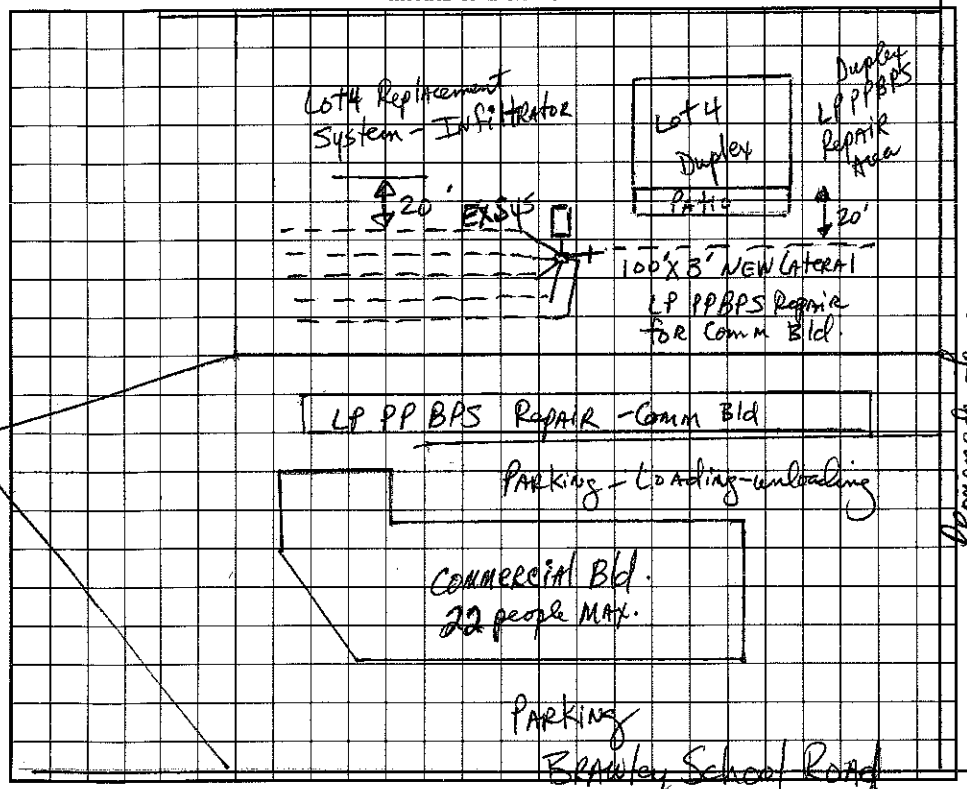

AS BUILT SKETCH

I understand that this permit can be suspended or revoked if any false information is supplied toward securing the permit/any unauthorized changes are made to the site/any unauthorized changes are made in the installation of the system. Improvement Permit is valid for 60 months from date of issuance.

Signed: Marilyn Reedy

Improvement Permit by: Jason R Johnson, RS date 5/19/95

Existing System Inspection by: date

Installed by: A Crum

Certificate of Completion by: date

Operation Permit by: JR Johnson, RS date 12-4-95

HEALTH DEPT. COPY: WHITE INSPECTION COPY (FINAL): GREEN OWNER COPY (FINAL): YELLOW INSPECTION COPY (INITIAL): PINK OWNER COPY (INITIAL): GOLD