IREDELL COUNTY HEALTH DEPARTMENT

AUTHORIZATION TO CONSTRUCT

STATESVILLE 704-878-5305 MOORESVILLE 704-664-5281

IMPROVEMENT PERMIT / ~~CERTIFICATE OF COMPLETION~~ / OPERATION PERMIT / EXISTING SYSTEM INSPECTION

PROPERTY DESCRIPTION NO. 2627 DATE 3/19/97 TAX MAP NO. 4637827865 Watershed: ☑ Yes ☐ No

OWNER OR CONTRACTOR JOHNNY R. WEBSTER PHONE: Business _____ Home 669-2048

ADDRESS 1442 BRAWLEY SCHOOL RD

LOCATION BRAWLEY SCHOOL RD - TR RESCUE LN - ON LEFT AT END

SUBDIVISION RAY WEBSTER BLOCK / SECTION _____ LOT 1 LOT AREA 4.21 AC SITE CLASS. PS DESIGN FLOW 360 GPD L.T.A.R. .36 PR/KS

Septic Tank: 1000 Gallons; STB 797 Date 5/22/98

Pump Tank: _____ Gallons; PT _____ Date _____

Pump Make: _____ Model _____ Serial No. _____

Nitrification Field: No Fields 1 Square Feet 1200 Linear Feet 400

No Lines 4 @ 100' Trench Width 36" Max Trench Bottom Depth 36" Gravel Depth 12"

☑ New System ☐ Repair System Type: I (II) III, IV, V, VI

System Description: GRAVITY CONVENTIONAL

Repair System Description: SAME

Maintenance Agreement Required: ☐ Yes ☑ No

☑ House/Mod. Home No. Bedrooms 3

☐ Mobile Home No. Bathrooms 2

☐ Business No. Employees ____

☐ Other _____


☐ Slab ☑ Crawl Space ☑ Basement w/plumbing ☐ Basement wo/plumbing

Water Supply: ☑ Individual ☐ Community ☐ Public


Comments:

Comments:

INITIAL SITE SKETCH

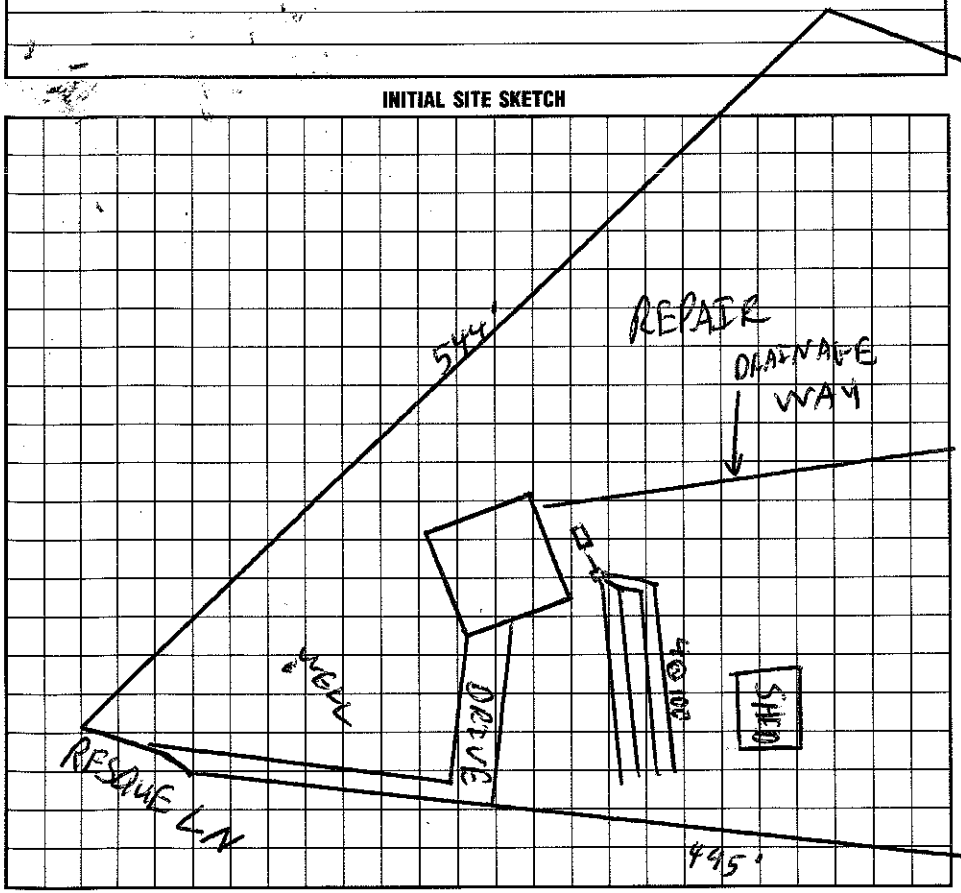

AS BUILT SKETCH

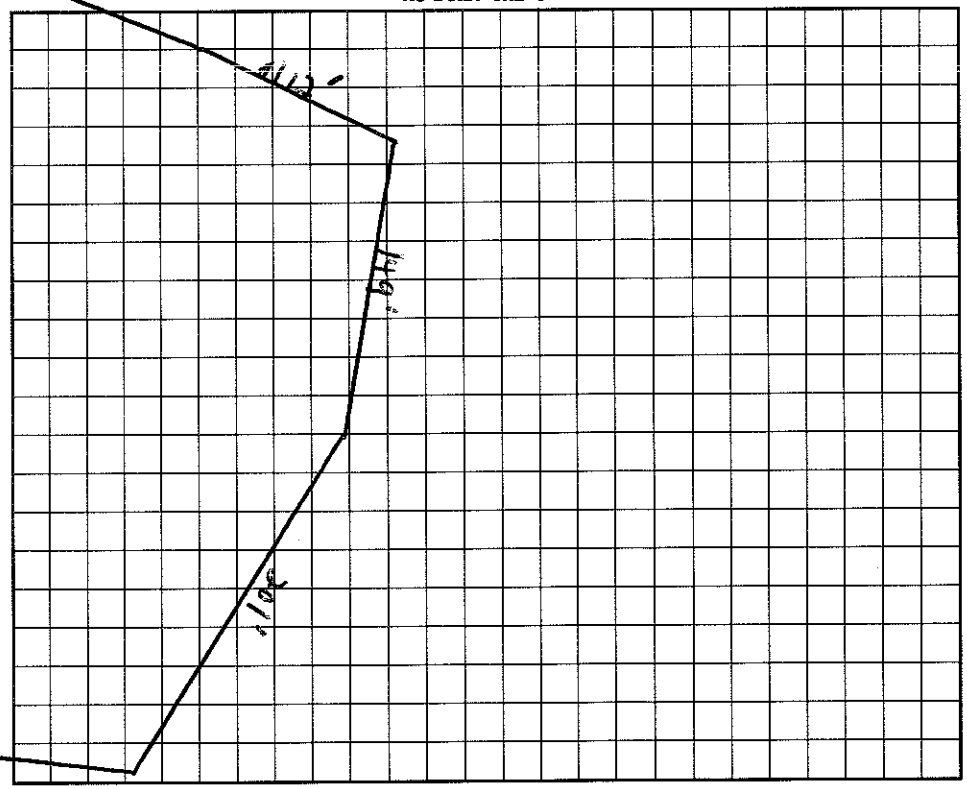

I understand that this permit can be suspended or revoked if any false information is supplied toward securing the permit/any unauthorized changes are made to the site/any unauthorized changes are made in the installation of the system. Improvement Permit is valid for 60 months from date of issuance.

Signed: Johnny Webster

Installed by: WORTH WEBSTER / JOHNNY WEBSTER

Improvement Permit by: C. Ray Freeman date 3/19/97

~~Existing System Inspection by:~~ _____ date _____

AUTHORIZATION TO CONSTRUCT C. Ray Freeman date 3/19/97

Certificate of Completion by: _____ date _____

Operation Permit by: C. Ray Freeman RS date 7/2/98

HEALTH DEPT. COPY: WHITE INSPECTION COPY (FINAL): GREEN OWNER COPY (FINAL): YELLOW INSPECTION COPY (INITIAL): PINK OWNER COPY (INITIAL): GOLD