# IREDELL COUNTY HEALTH DEPARTMENT

Authorization to Construct

STATESVILLE 704-878-5305 MOORESVILLE 704-664-5281

## IMPROVEMENT PERMIT / ~~CERTIFICATE OF COMPLETION~~ / OPERATION PERMIT / EXISTING SYSTEM INSPECTION

PROPERTY DESCRIPTION NO. 066135 DATE 5/12/97 TAX MAP NO. 4637902066 Watershed: ☒ Yes ☐ No

OWNER OR CONTRACTOR Newman McDade PHONE: Business 8872-7991 Home

ADDRESS PO Box 131 Mt Mourne, NC. 28123

LOCATION Brawley Sch Rd. TL Farmstead Lane to first lot on ®

SUBDIVISION Farmstead BLOCK / SECTION B LOT 70 LOT AREA .5 SITE CLASS. PS DESIGN FLOW 360 L.T.A.R. .3

Septic Tank: 1000 Gallons; STB Date

Pump Tank: Gallons; PT Date

Pump Make: Model Serial No.

Nitrification Field: No Fields 1 Square Feet 900* Linear Feet 300*

No Lines 4 Trench Width 36" Max Trench Bottom Depth 32" Gravel Depth SAND

☒ New System ☐ Repair System Type: I, II, (III) IV, V, VI

System Description: * GRAV-CH PLASTIC

Repair System Description:

Maintenance Agreement Required: ☐ Yes ☐ No

☐ House/Mod. Home No. Bedrooms 3

☐ Mobile Home No. Bathrooms 2

☐ Business No. Employees

☐ Other


☐ Slab ☐ Crawl Space ☐ Basement w/plumbing ☐ Basement wo/plumbing

Water Supply: ☐ Individual ☐ Community ☐ Public


Comments: See attached sheet for INSPECTION ACCESS DESIGN

Comments:

INITIAL SITE SKETCH

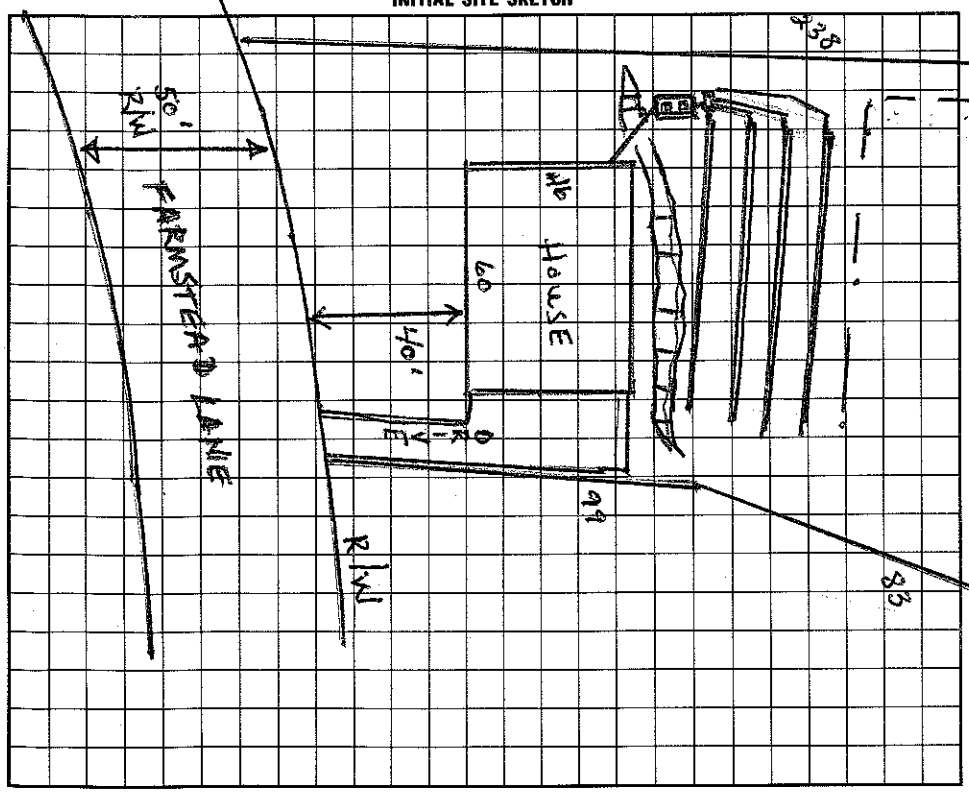


AS BUILT SKETCH

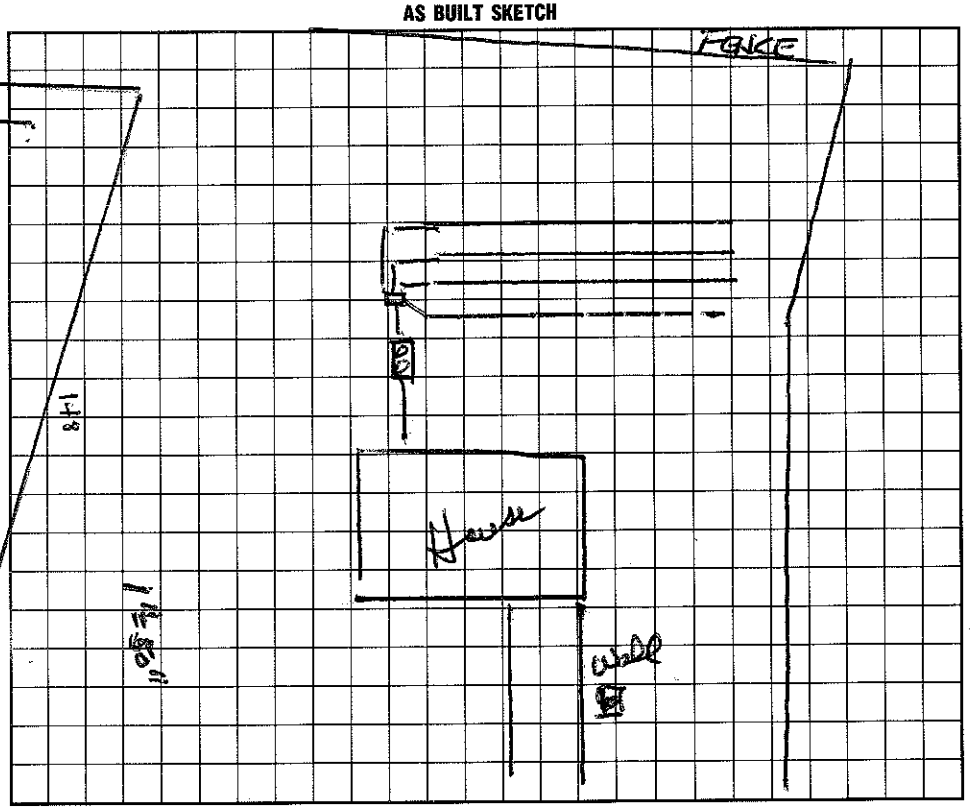


I understand that this permit can be suspended or revoked if any false information is supplied toward securing the permit/any unauthorized changes are made to the site/any unauthorized changes are made in the installation of the system. Improvement Permit is valid for 60 months from date of issuance.

Signed: * Newman McDade

Improvement Permit by: Wesley Sparks R.S. date 5/13/97

Existing System Inspection by: Wesley Sparks R.S. date 5/13/97

Installed by: Richard Abernathy

Certificate of Completion by: Wesley Sparks R.S. date 2/26/98

Operation Permit by: Wesley Sparks R.S. date 2/26/98

Access Road

HEALTH DEPT. COPY: WHITE INSPECTION COPY (FINAL): GREEN OWNER COPY (FINAL): YELLOW INSPECTION COPY (INITIAL): PINK OWNER COPY (INITIAL): GOLD