4637-90-3071

IREDELL COUNTY HEALTH DEPARTMENT

STATESVILLE 704-878-5305 MOORESVILLE 704-664-5281

IMPROVEMENT PERMIT / CERTIFICATE OF COMPLETION / OPERATION PERMIT / EXISTING SYSTEM INSPECTION

PROPERTY DESCRIPTION NO. 20920 DATE 5/23/95 TAX MAP NO. 2K-19-A-39 Watershed: ☒ Yes ☐ No

OWNER OR CONTRACTOR Baxter Burris PHONE: Business 663-5389 Home

ADDRESS R+9 # 912 Mallard Place Mooresville NC. 28115

LOCATION Farmstead Ln. (L) off Brawley School Rd. approx 1/3 mile on (R) below road

SUBDIVISION Farmstead Est. BLOCK / SECTION B LOT 69 LOT AREA 2.72 AC SITE CLASS. P DESIGN FLOW 360 L.T.A.R. .4

Septic Tank: 1000 Gallons; STB 794 Date 1/19/95

Pump Tank: Gallons; PT Date

Pump Make: Model Serial No.

Nitrification Field: No Fields 1 Square Feet 1200 Linear Feet 300

No Lines 3 Trench Width 36" Max Trench Bottom Depth 34" Gravel Depth 12"

☒ New System ☐ Repair System Type: I, (II), III, IV, V, VI

System Description: Gravity - Conventional

Repair System Description: Same

Maintenance Agreement Required: ☐ Yes ☒ No

☒ House/Mod. Home No. Bedrooms 3

☐ Mobile Home No. Bathrooms 2

☐ Business No. Employees

☐ Other


☐ Slab ☒ Crawl Space ☐ Basement w/plumbing ☐ Basement wo/plumbing

Water Supply: ☒ Individual ☐ Community ☐ Public

Comments:

Comments:

INITIAL SITE SKETCH

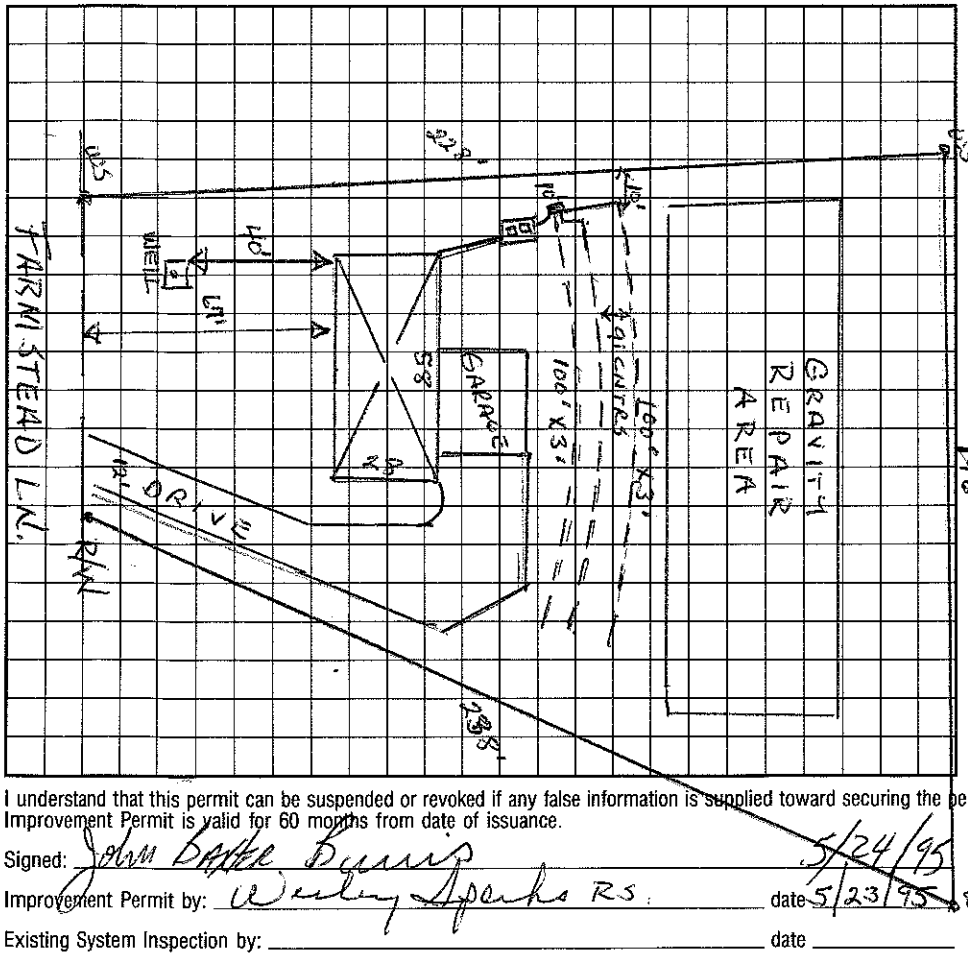

AS BUILT SKETCH

I understand that this permit can be suspended or revoked if any false information is supplied toward securing the permit/any unauthorized changes are made to the site/any unauthorized changes are made in the installation of the system. Improvement Permit is valid for 60 months from date of issuance.

Signed: John Baxter Burris 5/24/95

Improvement Permit by: Wesley Sparks RS. date 5/23/95

Existing System Inspection by: date

Installed by: Julian Bowles

Certificate of Completion by: Wesley Sparks RS date 9/22/95

Operation Permit by: date

HEALTH DEPT. COPY: WHITE INSPECTION COPY (FINAL): GREEN OWNER COPY (FINAL): YELLOW INSPECTION COPY (INITIAL): PINK OWNER COPY (INITIAL): GOLD