IREDELL COUNTY HEALTH DEPARTMENT

STATESVILLE 704-878-5305 MOORESVILLE 704-664-5281

IMPROVEMENT PERMIT / CERTIFICATE OF COMPLETION / OPERATION PERMIT / EXISTING SYSTEM INSPECTION

PROPERTY DESCRIPTION NO. 22606 DATE Oct. 2, 1995 TAX MAP NO. 7K19A1 Watershed: ☑ Yes ☐ No

OWNER OR CONTRACTOR Robert E. Kunkleman PHONE: ~~Business~~ PIN # 4637-90-3331 Home WSF

ADDRESS 1981 Hwy 73W, Davidson

LOCATION Beaverdam Sch. Rd. to Farmstead Lane 1st Lot on left

SUBDIVISION Farmstead BLOCK / SECTION 1 LOT 1 LOT AREA ≥ 20,000 ft² SITE CLASS. RS DESIGN FLOW 360 gpd L.T.A.R. .3

Septic Tank: 1000 Gallons; STB 1017 Date 4-16-96

Pump Tank: _____ Gallons; PT _____ Date _____

Pump Make: _____ Model _____ Serial No. _____

Nitrification Field: No Fields 1 Square Feet 900 Linear Feet 300

No Lines 3@100' Trench Width 36" Max Trench Bottom Depth 36" Gravel Depth N/A

☑ New System ☐ Repair System Type: I, II, III, IV, V, VI

System Description: gravity INF/Trench

Repair System Description: same

Maintenance Agreement Required: ☐ Yes ☑ No

☑ House/Mod. Home No. Bedrooms 3

☐ Mobile Home No. Bathrooms 2

☐ Business No. Employees ____

☐ Other _____

☐ Slab ☑ Crawl Space ☐ Basement w/plumbing ☐ Basement wo/plumbing


Water Supply: ☑ Individual ☐ Community ☐ Public

Comments:

Comments:

Not to scale

INITIAL SITE SKETCH

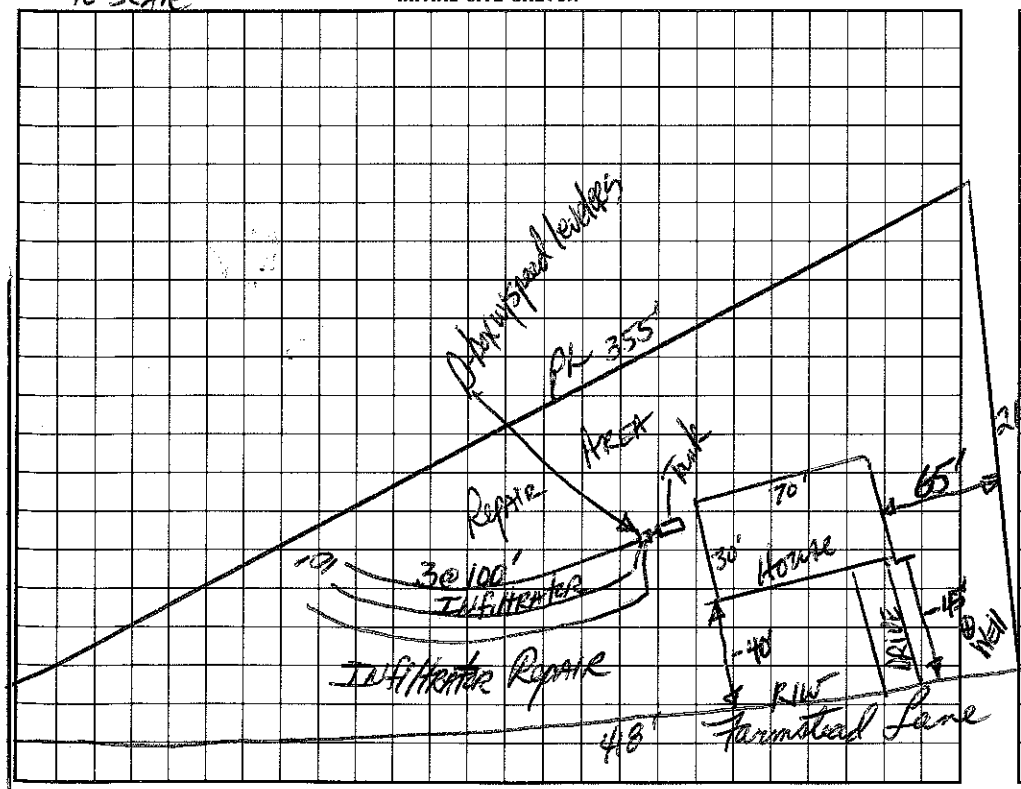

AS BUILT SKETCH

Same as initial Site Sketch

I understand that this permit can be suspended or revoked if any false information is supplied toward securing the permit/any unauthorized changes are made to the site/any unauthorized changes are made in the installation of the system.

Authorization for applicant is valid five (5) years from date of issuance

Signed: ~~X~~ Norman Robert Kunkleman

Improvement Permit by: J R Hanner, RS date 10/2/95

~~Existing System Inspection~~ by: J R Hanner, RS date 11/2/95

Authorization to reinspect

Installed by: Richard Abernathy

~~Certificate of Completion~~ by: _____ date _____

Operation Permit by: C. Bailey Lee date 6/19/96

HEALTH DEPT. COPY: WHITE INSPECTION COPY (FINAL): GREEN OWNER COPY (FINAL): YELLOW INSPECTION COPY (INITIAL): PINK OWNER COPY (INITIAL): GOLD