IREDELL COUNTY HEALTH DEPARTMENT

Authorization to Construct

(4130) 463791016?

STATESVILLE 704-878-5305 MOORESVILLE 704-664-5281

IMPROVEMENT PERMIT / ~~CERTIFICATE OF COMPLETION~~ / OPERATION PERMIT / EXISTING SYSTEM INSPECTION

PROPERTY DESCRIPTION NO. 23450 DATE 5/3/96 TAX MAP NO. 2K-A-70 Watershed: ☑ Yes ☐ No

OWNER OR CONTRACTOR Mooresville Rescue Squad PHONE: Business Home 873-4325 (PS West Co.)

ADDRESS 17007 Brawley School Rd

LOCATION (17007 Brawley School Rd) - Brawley School Rd - TR Rescue Lane before D & B Mart

SUBDIVISION — BLOCK / SECTION — LOT — LOT AREA 2 ac SITE CLASS PS DESIGN FLOW 150 gpd L.T.A.R. .3 gpd/ft²

Septic Tank: 1000 Gallons; STB 94 Date 9/19/96

Pump Tank: Gallons; PT Date

Pump Make: Model Serial No.

Nitrification Field: No Fields 1 Square Feet 495 Linear Feet 165

No Lines 3 Trench Width 36" Max Trench Bottom Depth 18" Gravel Depth 12"

☑ New System ☐ Repair System Type: I (II) III IV V VI

System Description: Gravity Conv.

Repair System Description: Gravity Chambered

Maintenance Agreement Required: ☐ Yes ☐ No

☐ House/Mod. Home No. Bedrooms

☐ Mobile Home No. Bathrooms

☑ Business No. Employees 6

☐ Other


☐ Slab ☐ Crawl Space ☐ Basement w/plumbing ☐ Basement wo/plumbing

Water Supply: ☐ Individual ☐ Community ☑ Public


Comments: 18" trench Bottom w/ 6" cover.

Comments:

INITIAL SITE SKETCH Not to Scale

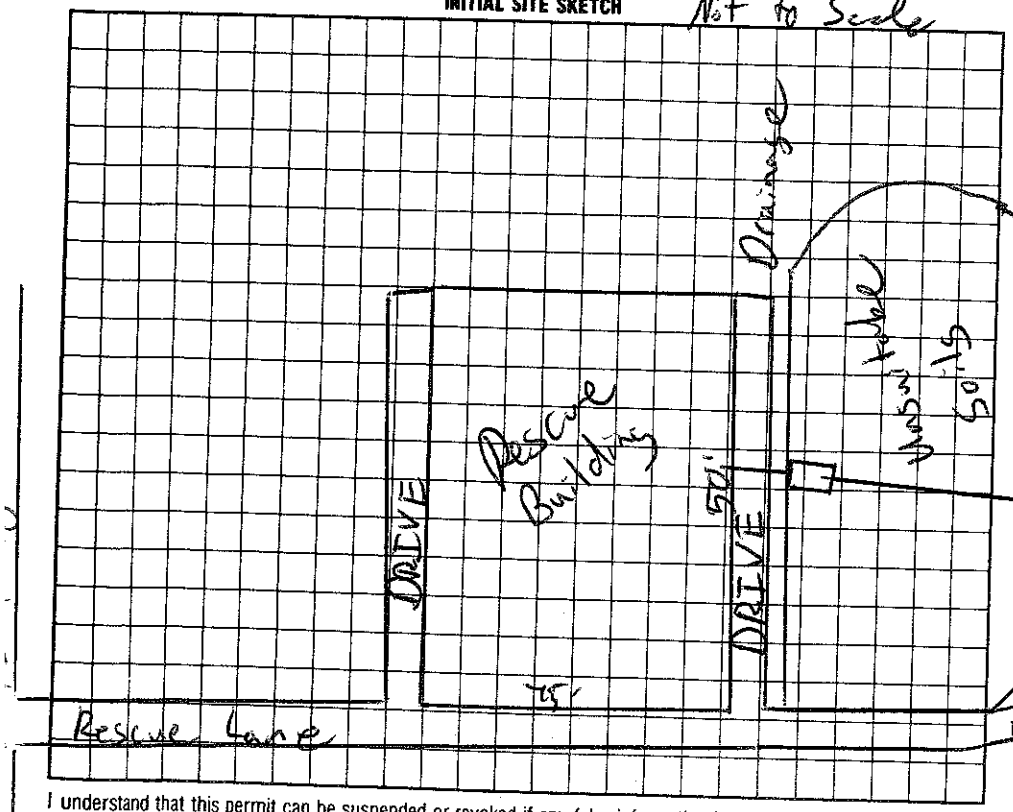

AS BUILT SKETCH

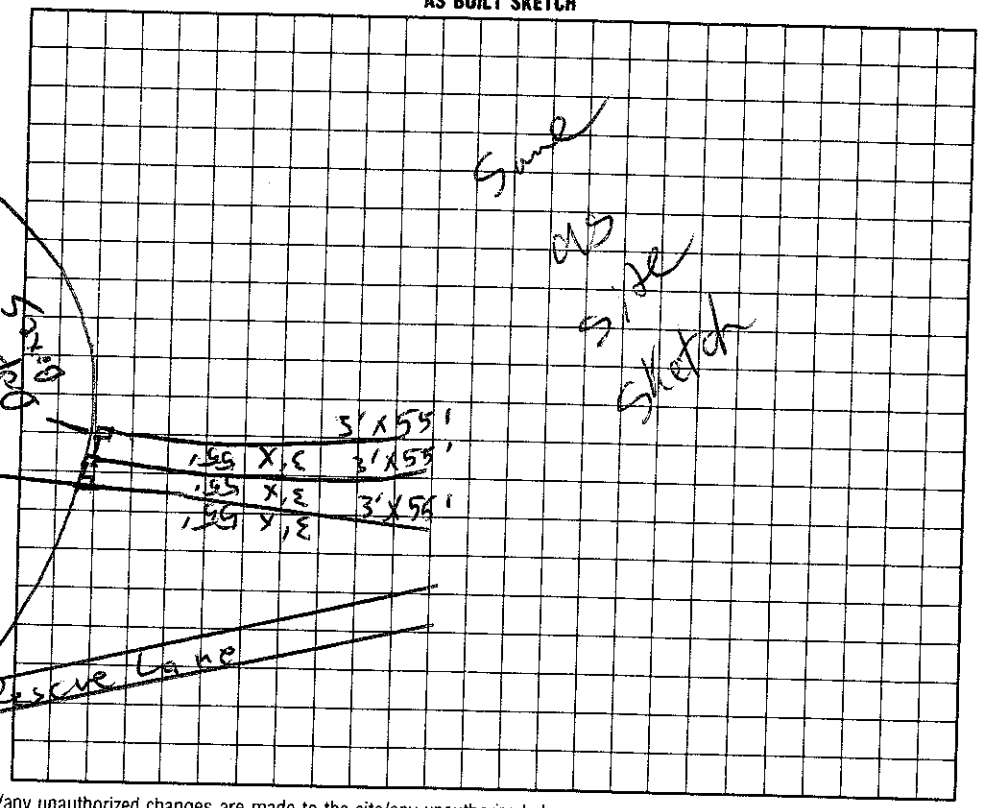

I understand that this permit can be suspended or revoked if any false information is supplied toward securing the permit/any unauthorized changes are made to the site/any unauthorized changes are made in the installation of the system.

Signed: Bill Bull

Improvement Permit by: C. Ruby Turner REHS date 6/3/96

~~Authorization to Construct~~ by: C. Ruby Turner REHS date 6/3/96

~~Existing System Inspection~~ by:

Installed by: RAY BEAM

Certificate of Completion by: date

Operation Permit by: C. Ruby Turner date 11/7/96

HEALTH DEPT. COPY: WHITE INSPECTION COPY (FINAL): GREEN OWNER COPY (FINAL): YELLOW INSPECTION COPY (INITIAL): PINK OWNER COPY (INITIAL): GOLD

Authorization to construct is valid for 60 months