IREDELL COUNTY HEALTH DEPARTMENT

AUTHORIZATION TO CONSTRUCT

(1080-)

STATESVILLE 704-878-5305 MOORESVILLE 704-664-5281

IMPROVEMENT PERMIT / ~~CERTIFICATE OF COMPLETION~~ / OPERATION PERMIT / EXISTING SYSTEM INSPECTION

PROPERTY DESCRIPTION NO. 26208 DATE 3/19/97 TAX MAP NO. 4637921860 Watershed: ☑ Yes ☐ No

OWNER OR CONTRACTOR WORTH WEBSTER PHONE: Business _____ Home 664-2048

ADDRESS 1442 BRAWLEY SCHOOL RD MOORESVILLE 28115

LOCATION BRAWLEY SCHOOL - TR RESQUE LN AT END

SUBDIVISION RAY WEBSTER BLOCK / SECTION _____ LOT 2 LOT AREA 3.234C SITE CLASS. PS DESIGN FLOW 360GPD L.T.A.R. .360/PT

Septic Tank: 1000 Gallons; STB 794 Date 3/18/98

Pump Tank: _____ Gallons; PT _____ Date _____

Pump Make: _____ Model _____ Serial No. _____

Nitrification Field: No Fields 1 Square Feet 1200 Linear Feet 400

No Lines 5 @ 80' Trench Width 36" Max Trench Bottom Depth 36" Gravel Depth 12"

☑ New System ☐ Repair System Type: I (II) III, IV, V, VI

System Description: GRAVITY CONVENTIONAL

Repair System Description: SAME

Maintenance Agreement Required: ☐ Yes ☑ No

☑ House/Mod. Home No. Bedrooms 3

☐ Mobile Home No. Bathrooms 2

☐ Business No. Employees ____

☐ Other _____

☐ Slab ☑ Crawl Space ☐ Basement w/plumbing ☐ Basement wo/plumbing

Water Supply: ☑ Individual ☐ Community ☐ Public

Comments:

126


137

148


156

Comments:

INITIAL SITE SKETCH

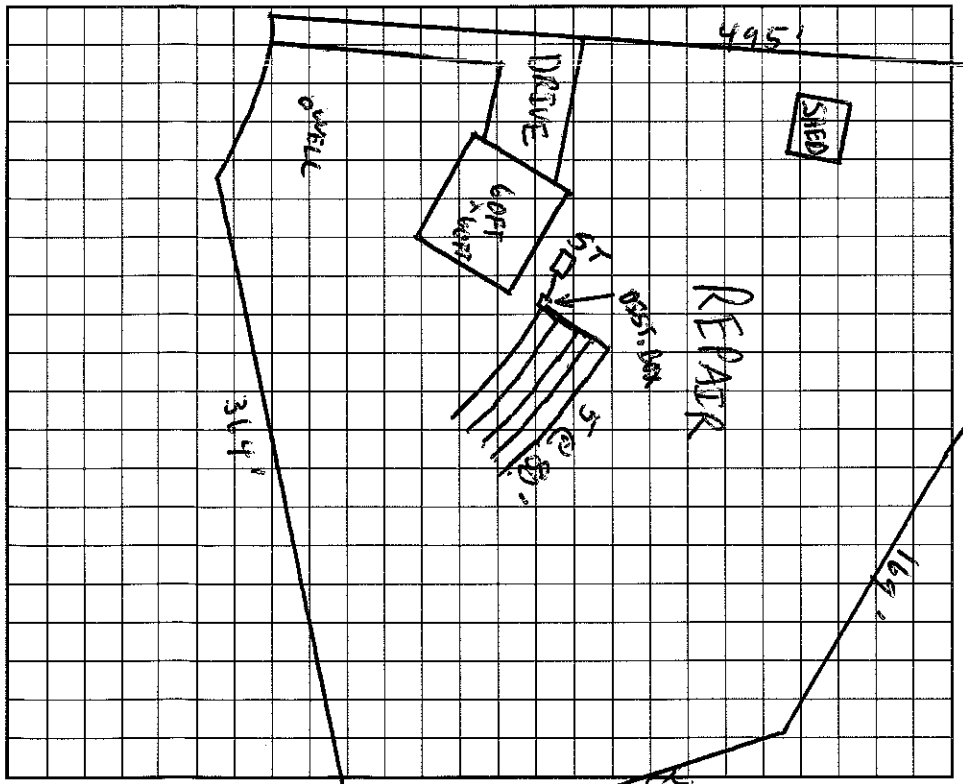

AS BUILT SKETCH

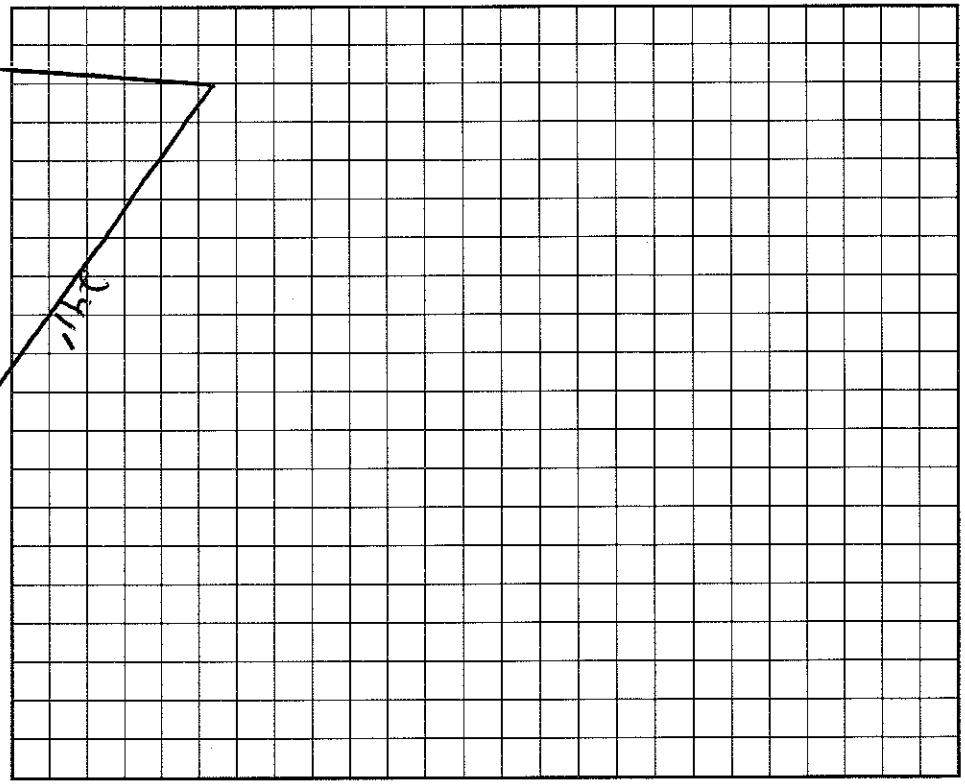

I understand that this permit can be suspended or revoked if any false information is supplied toward securing the permit/any unauthorized changes are made to the site/any unauthorized changes are made in the installation of the system. Improvement Permit is valid for 60 months from date of issuance.

Signed: Not Webster

Installed by: WORTH WEBSTER

Improvement Permit by: C. R. Zoeller date 3/19/97

Certificate of Completion by: _____ date _____

Existing System Inspection by: AUTHORIZATION TO CONSTRUCT C. R. Zoeller date 3/19/97

Operation Permit by: C. R. Zoeller date 7/1/98

HEALTH DEPT. COPY: WHITE INSPECTION COPY (FINAL): GREEN OWNER COPY (FINAL): YELLOW INSPECTION COPY (INITIAL): PINK OWNER COPY (INITIAL): GOLD