IREDELL COUNTY HEALTH DEPARTMENT

STATESVILLE 704-878-5305 $50 a MOORESVILLE 704-664-5281

IMPROVEMENT PERMIT / AUTHORIZATION TO CONSTRUCT / OPERATION PERMIT / EXISTING SYSTEM INSPECTION

PERMIT# 069121 PIN# 4638014272 / PT 4638-01-5376 DATE 7/3/02

OWNER OR CONTRACTOR CLAT / GLENN HEILIG PHONE: Business 663 6406 - JACOBS Home

ADDRESS PO BOX 1003 CHARLOTTE NC 28201

LOCATION 150W - TR WADDELL RD - TR HERMANCE. HOUSE ON RT - DRAINFIELD ON LT

SUBDIVISION CLAT BLOCK / SECTION 11 LOT 1 LOT AREA .789AC SITE CLASS. PS DESIGN FLOW ~~360~~ 360 L.T.A.R. .36 RD/FT =

Septic Tank: 1000 Gallons; STB 766 Date 4/1/03

Pump Tank: 1000 Gallons; PT 363 Date 6/16/03

Pump Make: ZOELLER Model N-163G Serial No. 6/25/2003

Nitrification Field: No Fields 1 Square Feet 1200 Linear Feet 400

No Lines 3@133' Trench Width 36" Max Trench Bottom Depth 36" Gravel Depth 12"

☑ New System ☐ Repair System Type: I, II, (III), IV, V, VI

System Description: PUMP CONVENTIONAL

Repair System Description: SAME

Maintenance Agreement Required: ☐ Yes ☑ No

☑ House/Mod. Home No. Bedrooms 3

☐ Mobile Home No. Bathrooms 3

☐ Business No. Employees

☐ Other


☐ Slab ☑ Crawl Space ☐ Basement w/plumbing ☐ Basement wo/plumbing

Water Supply: ☑ Individual ☐ Public ☐ Community


Comments:/Conditions:

Comments:/Conditions:

INITIAL SITE SKETCH 1"=60'

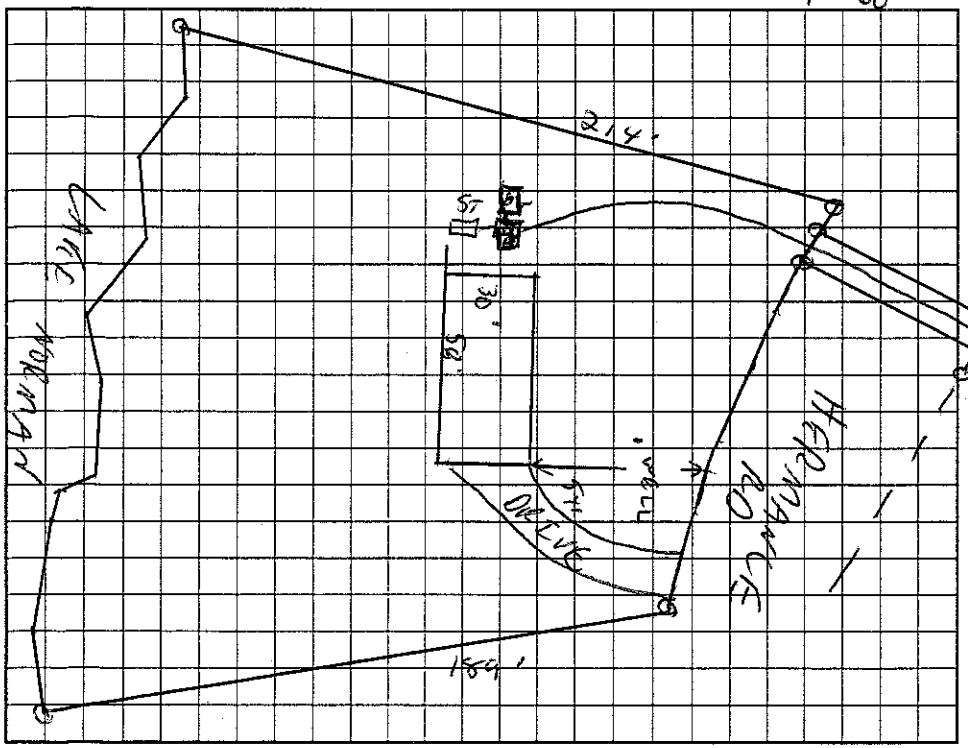

AS BUILT SKETCH

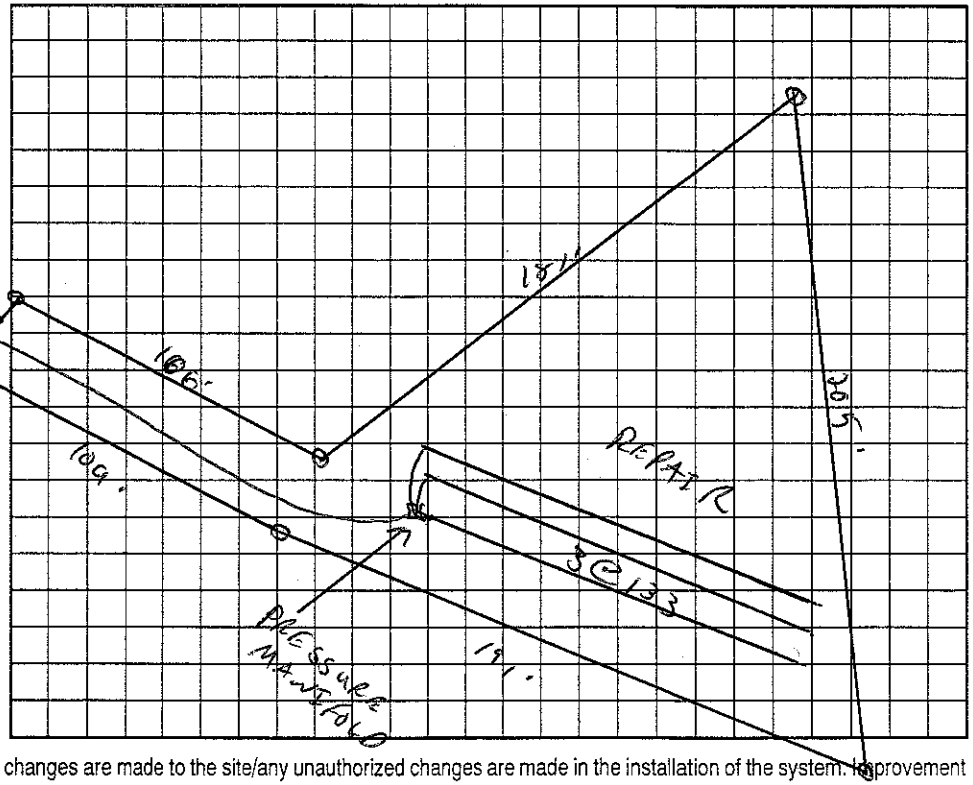

Permit can be suspended or revoked if any false information is supplied toward securing the permit/any unauthorized changes are made to the site/any unauthorized changes are made in the installation of the system. Improvement Permit with plat valid without expiration. Improvement Permit with site plan valid for sixty months. Authorization to Construct is valid for a period equal to that of Improvement Permit – not to exceed sixty months.

Signed: _____ date _____ Installed by: Myers Septic

Improvement Permit by: _____ RS date 7/3/02 Operation Permit by: _____ RS date 11/14/03

Authorization to Construct by: _____ RS date 7/3/02 Existing System Inspection by: _____ date _____

HEALTH DEPT. COPY: WHITE OWNER COPY (FINAL): YELLOW OWNER COPY (INITIAL): PINK