IREDELL COUNTY HEALTH DEPARTMENT

Statesville Office (704) 878-5305 | Mooresville Office (704) 660-3625 | PERMIT # 208901

IMPROVEMENT PERMIT / AUTHORIZATION TO CONSTRUCT / OPERATION PERMIT / EXISTING SYSTEM

PIN # 4638-01-6823

APPLICANT: KILL WITHERALL | APPLICANT ADDRESS: 226 HERMANCE RD.

SITE ADDRESS: 220 HERMANCE LN; MESVL | PHONE: | ALT. PHONE:

SITE DIRECTIONS: 150 W. TR WADDELL, TR HERMANCE ON R

SUBDIVISION: CLET | SECTION: 11 | LOT # 237 | LOT AREA: .71 AC | DESIGN FLOW: 360 | L.T.A.R.: .3

Septic Tank 1000 (gal) | STB | Date
Pump Tank 1000 (gal) | PT | Date
Pump Make | Model | Serial #
Nitrification Fields 1 | # Lines 3 | Linear Ft: 67'
Trench Width 24" | Max. Trench Bottom Depth 36" | Gravel Depth

☐ New System ☐ Repair ☒ Expansion | System Type: I II (III)B IV V VI
System Description: PM PANEL BLOCK
Repair System Description: DRIP
Maintenance Agreement Required: ☐ YES ☒ NO
☐ GRAVITY ☒ PRESSURE

☒ Residence ☐ Business ☐ Other ☐ Slab ☒ Basement w/plumbing
No. Bedrooms 3 | No. Persons | No. Employees | ☐ Crawl Space | ☐ Basement w/o plumbing

Water Supply: ☒ Private ☐ Public ☐ Community

Comments / Conditions:

INITIAL SITE SKETCH

SEE PLAN FROM MICHAEL ATHANAS & ASSOCIATES

AS BUILT SKETCH

CHECKED TANKS 5-12-16 BA
5/16/16 Checked lines MD
5-24-16 Distribution Inspection
Pressure Manifold
1½" SCH 40 Tap
Box (equally distributing w/ speed levelers)
1½" SCH 40 Taps
22'
22'
23'

Permit can be suspended or revoked if any false information is supplied toward securing the permit / any unauthorized changes are made to the site / any unauthorized changes are made in the installation of the system. **CONTACT A LOCATOR SERVICE PRIOR TO ANY EXCAVATION**

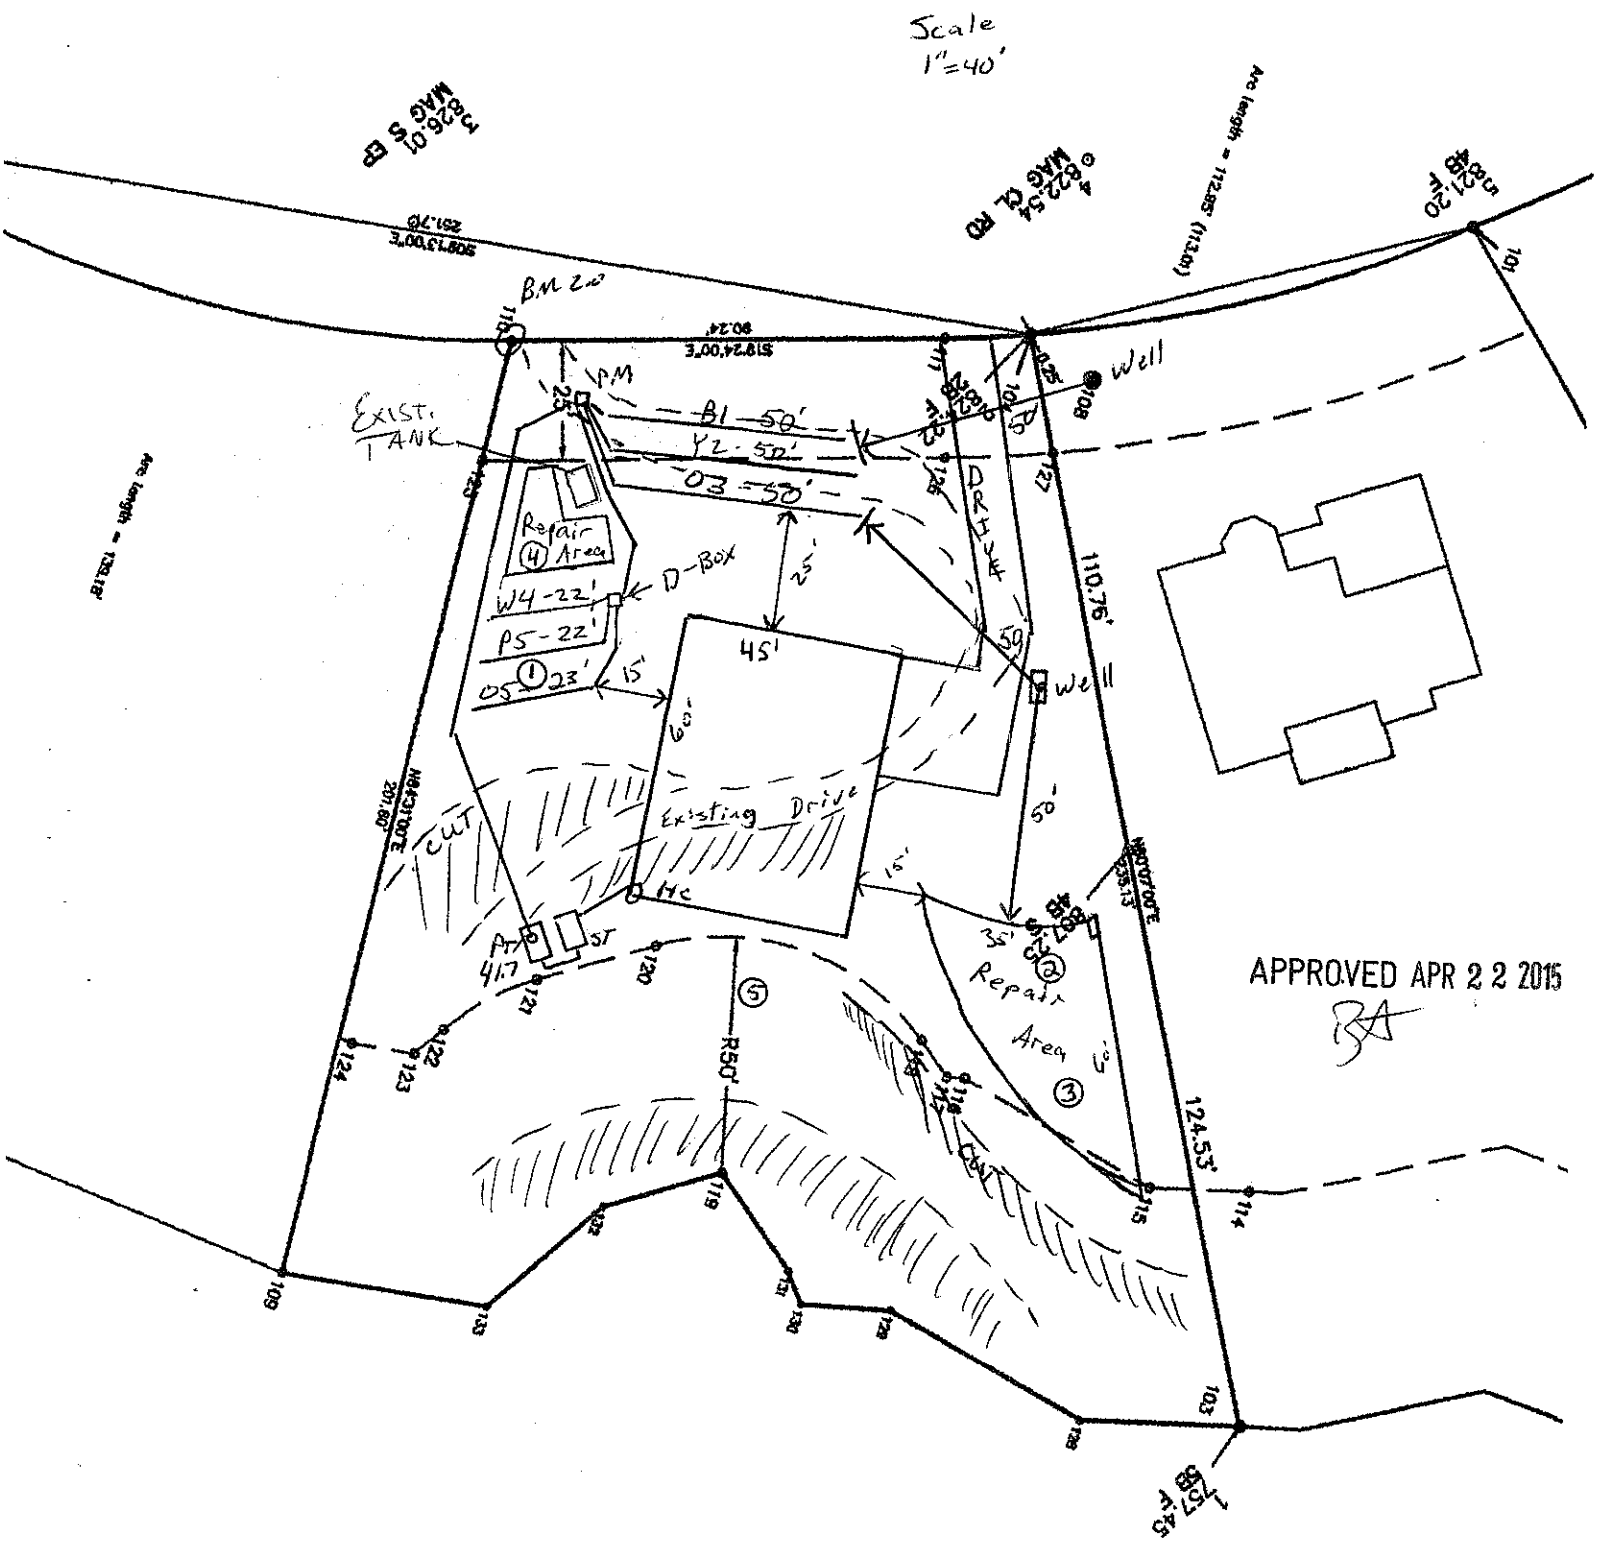
☐ **IMPROVEMENT PERMIT** *with plat valid without expiration.* ☒ **IMPROVEMENT PERMIT** *with site plan valid for 60 mos.* ☒ **AUTHORIZATION TO CONSTRUCT** *valid for period equal to IMPROVEMENT PERMIT--not to exceed 60 mo.*

Owner / Applicant Signature: | Date: 5/8/2015 | Installed by: ABERNATHY

IMPROVEMENT PERMIT by: APPROVED | Date: APR 22 2015 | OPERATION PERMIT by: | Date: 7-20-16

AUTHORIZATION TO CONSTRUCT by: APPROVED | Date: MAY 13 2015 | Existing System Inspected by: | Date:

Health Dept. Copy - WHITE Applicant (Final Approval) - YELLOW Applicant (Conditional Approval) - PINK


Scale
1"=40'
BM 2.0
IPM
EXIST. TANK
B1 - 50'
Y2 - 50'
-03 - 50'
Repair Area ④
W4 - 22'
P5 - 22'
D-Box
25'
45'
15'
60'
Existing Drive
CUT
DRIVE
Well
110.76'
50'
Repair Area ③
Repair Area ②
R50'
124.53'
APPROVED APR 2 2 2015