3:30

IREDELL COUNTY HEALTH DEPARTMENT

STATESVILLE 704-878-5305 MOORESVILLE 704-664-5281

IMPROVEMENT PERMIT / AUTHORIZATION TO CONSTRUCT / OPERATION PERMIT / EXISTING SYSTEM INSPECTION

PERMIT# Repair PIN# 4628 92 9678 DATE 5-16-08

OWNER OR APPLICANT Andrew Simpson PHONE: Business Home 704-663-3986

ADDRESS 268 Hermance Ln Mooresville NC

LOCATION Same

SUBDIVISION CL+T BLOCK / SECTION 2 LOT 244 LOT AREA SITE CLASS. PS DESIGN FLOW 360 L.T.A.R. .8

Septic Tank: Existing Gallons: STB 1000 gal Date

Pump Tank: 1000 d Gallons: PT 3630 Date 4-16-08

Pump Make: Goulds Model WE05T2H44 Serial No. 1/2 hp

Nitrification Field: No Fields 1 Square Feet 900' Linear Feet 300'

No Lines 5 @ 60' Trench Width 36" Max Trench Bottom Depth 36" Gravel Depth — ☐ Gravity ☒ Pressure

☐ New System ☒ Repair ☐ Expansion System Type: I II III IV V VI

System Description:

Repair System Description: Pm 25% Red.

Maintenance Agreement Required: ☐ Yes ☒ No

☐ House/Mod. Home ☒ Mobile Home ☐ Business ☐ Other


No. Bedrooms 3 No. Persons 2 No. Employees

Water Supply: ☒ Individual ☐ Public ☐ Community

☐ Slab ☒ Crawl Space ☐ Basement w/plumbing ☐ Basement wo/plumbing

Comments:/Conditions: LKN

INITIAL SITE SKETCH

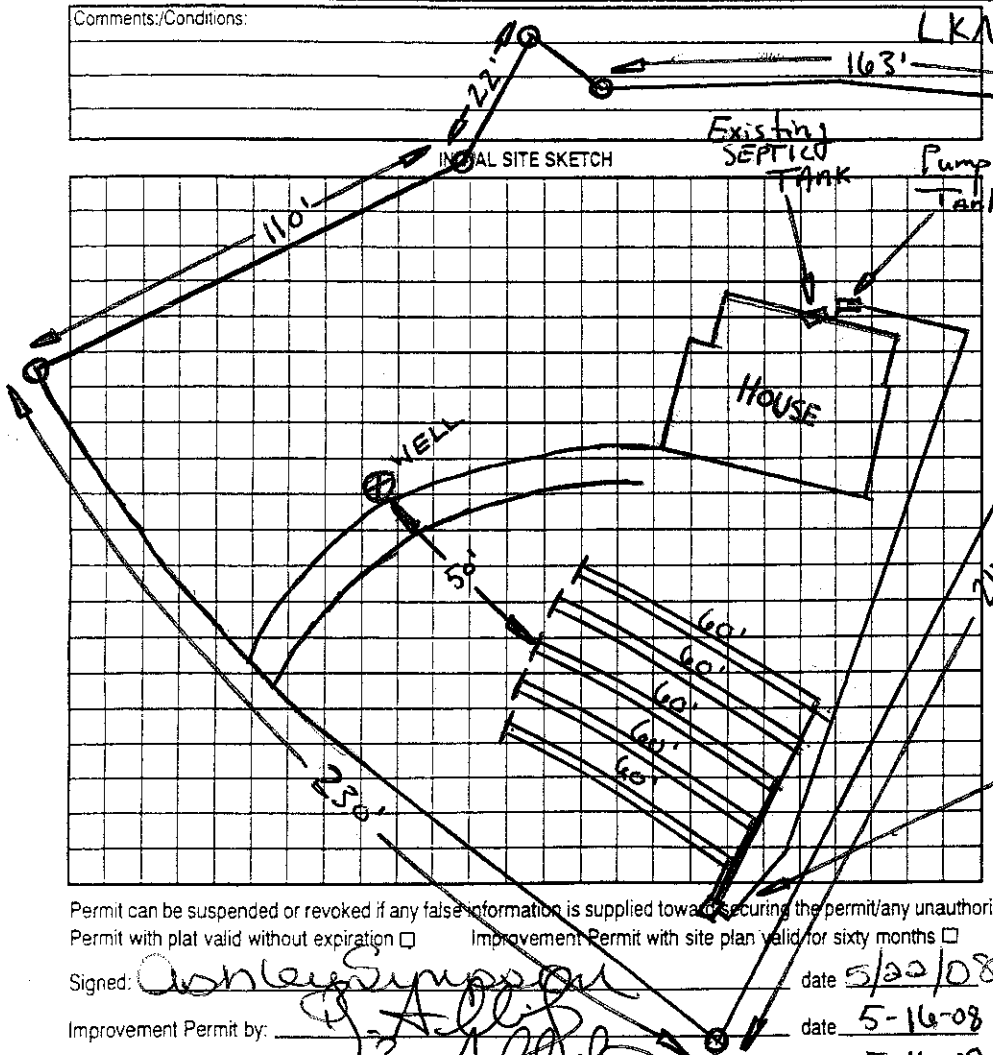

Comments:/Conditions: Be sure drain lines Are no closer than 50' to the well / Installed 5@60' Quik4

AS BUILT SKETCH

Permit can be suspended or revoked if any false information is supplied toward securing the permit/any unauthorized changes are made to the site/any unauthorized changes are made in the installation of the system. Improvement Permit with plat valid without expiration ☐ Improvement Permit with site plan valid for sixty months ☐ Authorization to Construct is valid for a period equal to that of Improvement Permit – not to exceed sixty months.

Signed: Andrew Simpson date 5/22/08 Installed by: Stanley

Improvement Permit by: B. A. Kelly date 5-16-08 Operation Permit by: B. A. Kelly date 5-5-08

Authorization to Construct by: B. A. Kelly date 5-16-08 Existing System Inspection by: date

HEALTH DEPT. COPY: WHITE OWNER COPY (FINAL): YELLOW OWNER COPY (INITIAL): PINK