IREDELL COUNTY HEALTH DEPARTMENT

Statesville Phone TR 3-7271 Mooresville Phone NO 3-1271

PERMIT TO INSTALL SEPTIC TANK

Permit No. 83 Permit Date 7-14 1971

Owner Mitch Albright Address Statesville, NC

Installed By Norman Eric Address Mooresville, N.C.


Location of Property 150 W. Turn Right on Road #1396 - Section 11 - Lot 204

Tank		Capacity		Length of Lines		Fixtures	
Block	( )	1000	(✓)	225'	(✓)	No. of Baths	(1)
Precast	(✓)	1250	( )	250'	( )	Dishwasher	( )
		1500	( )	Other		Garbage Grdr.	( )
		Other				Other	

NOTIFY HEALTH DEPARTMENT AT LEAST EIGHT HOURS BEFORE TANK IS TO BE INSPECTED.

Final Inspection 7-16 1971 Approved (✓) Disapproved ( )

Remarks

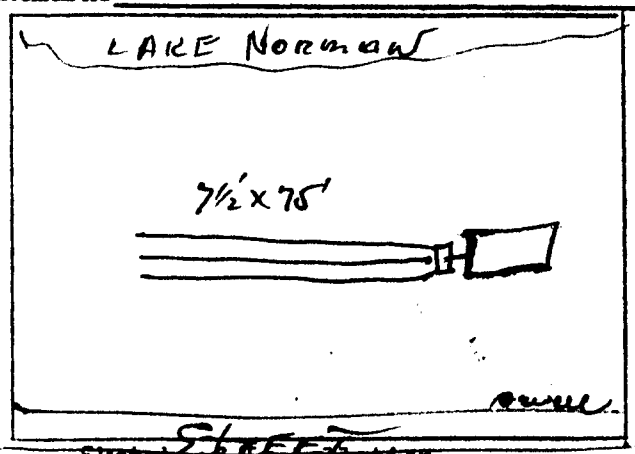

Sketch of Installation

Sanitarian